

LIBER 20101 PG 702

LAND CORNER RECORDATION CERTIFICATE
Filing Requirement of Act 74, Mich. P.A. 1970

206142

For corners in

OAKLAND

(County)

PONTIAC

Located In: TWP. Corner Code # G-9

LIBER 20101 PAGE 702
\$7.00 MISC RECORDING
\$2.00 REMONUMENTATION
06/10/1999 12:32:43 P.M. RECEIPT# 41597
PAID RECORDED - OAKLAND COUNTY
G. WILLIAM CADDELL, CLERK/REGISTER OF DEEDS

Compliance with
ACT 345, P.A. 1990

APPROVED ON: 4-21-99 JS
OAKLAND COUNTY REMONUMENTATION
PEER GROUP COMMITTEE

Register of Deeds Stamp & File Number

1. Public Land Survey

T 3N R 10E G-9

T R

T R

T R

S T R

S T R

S T R

S T R

SURVEY &
REMONUMENTATION
MAR 21 2000

SECTION

2. Property Controlling
in Section

3. Miscellaneous
Property in Sec.

4. Lot No. _____, Recorded Plat _____

5. Private Claims _____

RAYMOND J. McCOY

April 8 99


I, _____, in a field survey on _____, 19____ do hereby state that under requirements of P.A. 74, Michigan P.A. of 1970, the corner points mentioned in lines 1 and 2 above were in conformance with regulations and rules therefore as required in the current manual of survey instructions of the United States Department of the Interior, Bureau of Land Management or by a decree of a Court of Law and /or that the corner points mentioned in lines 3, 4 and 5 above were in conformance with the rules of the Michigan Board of Land Surveyors or by a Decree of a Court of Law; established, re-established, monumented, recovered, found as expressed below:

NOTE: Not more than 2 corners, all in the same town and range, may be recorded on this certificate.

	A	B	C	D	E	F	G	H	I	J	K	L	M
1													
2	6		5		4		3		2		1		
3													
4	7		8		9		10		11		12		
5													
6	18		17		16		15		14		13		
7													
8	19		20		21		22		23		24		
9													
10	30		29		28		27		26		25		
11													
12	31		32		33		34		35		36		
13													

A. Description of original monument and accessories and/or subsequent restoration:

WAMPLER, D.S., SET POST
THERE ARE NO LCRC'S RECORDED.

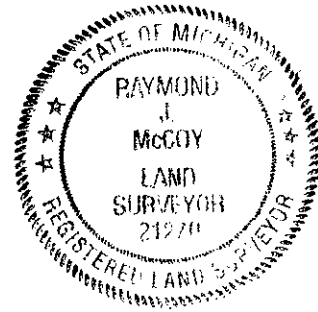

B. Description of corner evidence found and/or method applied in restoring or reestablishing corner:

No corner was found. The corner was established by using monumentation found in "ASSESSOR'S PLAT NO. 103"(L.48, Pg. 16 & 16A, 1928), more particularly using irons found on the southerly line of said plat. The dimensions between the found irons fits very close to the recorded measurements.

STATE PLANE COORDINATES N 420534.6249
E 13418501.2858

C. Description of monument for corner and accessories established to perpetuate locating the position of the corner:

Set a concrete monument consisting of a 1/2" iron rod encased in a 4" diameter concrete cylinder 36" long with a 2" diameter brass disk stamped Oakland County Remonumentation P.S. #21270.

Witnesses:

South, 5.50, Set OCRT #21270 in West face of Guardrail Post.
S 87° W, 22.31, Set OCRT #21270 in North face of Power Pole
N 30° W, 48.22, Set OCRT #21270 in East face of 16" ELM
S 87° E, 83.53, Set OCRT #21270 in South face of 12" ELM

THE SELECTED LOCATION IS ACCEPTED BY ME AND IS GENERALLY ACCEPTED BY PROFESSIONAL SURVEYORS AS THE BEST AVAILABLE EVIDENCE OF THE POSITION OF THE ORIGINAL CORNER.

Signed by Raymond J. McCoy
Surveyor's Michigan License No. 21270

Date May 28, 1999