

LIBER 19629PG336

LAND CORNER RECORDATION CERTIFICATE 71712
Filing Requirement of Act 74, Mich. P.A. 1970

For corners in

Oakland
(County)

Located in Pontiac Corner Code #
Twp.

1. Public Land Survey

T3N R10E G-13

2. Property Controlling
in Section

S T R
S T R

3. Miscellaneous
Property in Sec.

S T R
S T R

SURVEY &
REMONUMENTATION

MAR 21 2000

SECTION

\$7.00 MISC RECORDING
\$2.00 REMONUMENTATION
03/03/1999 03:32:14 P.M. RECEIPT# 4986
PAID RECORDED - OAKLAND COUNTY
G. WILLIAM CADDELL, CLERK/REGISTER OF DEEDS

Compliance with
ACT 345, P.A. 1990

APPROVED ON: 1-13-99 JS
OAKLAND COUNTY REMONUMENTATION
PEER GROUP COMMITTEE

Register of Deeds Stamp & File Number

4. Lot No. _____, Recorded Plat _____

5. Private Claims _____

Raymond J. McCoy in a field survey on Dec. 4, 1998 do hereby state that under requirements of P.A. 74, Michigan P.A. of 1970, the corner points mentioned in lines 1 and 2 above were in conformance with regulations and rules therefore as required in the current manual of survey instructions of the United States Department of the Interior, Bureau of Land Management or by a decree of a Court of Law and /or that the corner points mentioned in lines 3, 4 and 5 above were in conformance with the rules of the Michigan Board of Land Surveyors or by a Decree of a Court of Law; established, re-established, monumented, recovered, found as expressed below:

	A	B	C	D	E	F	G	H	I	J	K	L
1												
2	6		5		4		3		2		1	
3												
4	7		8		9		10		11		12	
5												
6	18		17		16		15		14		13	
7												
8	19		20		21		22		23		24	
9												
10	30		29		28		27		26		25	
11												
12	31		32		33		34		35		36	
13												

NOTE: Not more than 2 corners, all in the same town and range, may be recorded on this certificate.

A. Description of original monument and accessories and/or subsequent restoration:
1817 G.L.O. Wampler D.S. Set post

No L.C.R.C.'s were recorded.

B. Description of corner evidence found and/or method applied in restoring or reestablishing corner:
Recovered empty monument box 15'± West of the centerline of MLK Blvd. and 2' North of the centerline of South Blvd.

Validated the centerline of the empty mon. box by monumentation in "Ferry Farms Addition" L.5, Pg.45, and by "South Park" L.47, Pg.21.


State Plane Corrdinate N 410017.3376
E 13418950.3500

C. Description of monument for corner and accessories established to perpetuate locating the position of the corner:
Set 5/8"x24" iron rod w/2" dia. brass disk stamped Oakland County Remonumentation P.S. #21270 in the centerline of the monument box.

Witnesses: Due East 374.87' Found Re-mon disk in mon box.
N15°W 175.64' Set O.C.R.T. #21270 in E face of P.P.
N25°E 166.59' Set O.C.R.T. #21270 in W face of P.P.
S45°W 60.12' Set O.C.R.T. #21270 in SW face of P.P.
S45°E 97.54' Set O.C.R.T. #21270 in N face of P.P.

The selected location is accepted by me and is generally accepted by Professional Surveyors as the best available evidence of the position of the original corner.

Signed by Raymond J. McCoy
Surveyor's Michigan License No. 21270

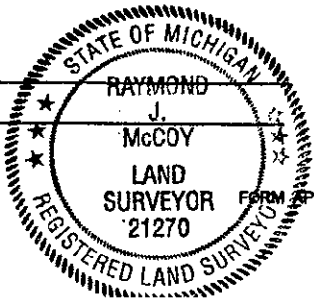

Date Jan 21 1999