

LAND CORNER RECORDATION CERTIFICATE
Filing Requirement of Act 74, Mich. P.A. 1970

126763

For corners in

LIBER 19827 PAGE 760
\$7.00 MISC RECORDING
\$2.00 REMONUMENTATION
04/13/1999 01:46:43 P.M. RECEIPT# 18471
PAID RECORDED - OAKLAND COUNTY
G. WILLIAM CADDELL, CLERK/REGISTER OF DEED

Oakland
(County)

Located In Pontiac Corner Code #
Twp.

1. Public Land Survey

T 3N R 10E H-5
T R
T R RE
T R

2. Property Controlling in Section

S T R
S T R
S T R

3. Miscellaneous Property in Sec.

S T R
S T R
SECTION

Compliance with
ACT 345, P.A. 1990

APPROVED ON: 2-17-99 JS
OAKLAND COUNTY REMONUMENTATION
PEER GROUP COMMITTEE

Register of Deeds Stamp & File Number

4. Lot No. _____, Recorded Plat _____
5. Private Claims _____

I, Raymond J. McCoy in a field survey on Feb. 1, 1999 do hereby state that under requirements of P.A. 74, Michigan P.A. of 1970, the corner points mentioned in lines 1 and 2 above were in conformance with regulations and rules therefore as required in the current manual of survey instructions of the United States Department of the Interior, Bureau of Land Management or by a decree of a Court of Law and /or that the corner points mentioned in lines 3, 4 and 5 above were in conformance with the rules of the Michigan Board of Land Surveyors or by a Decree of a Court of Law; established, re-established, monumented, recovered, found as expressed below:

NOTE: Not more than 2 corners, all in the same town and range, may be recorded on this certificate.

| | | | | | | | | | | | | | |
|----|----|---|----|---|---|----|---|----|---|----|---|---|----|
| | A | B | C | D | E | F | G | H | I | J | K | L | M |
| 1 | | | | | | | | | | | | | |
| 2 | 6 | 5 | | | | 4 | | 3 | | 2 | | | 1 |
| 3 | | | | | | | | | | | | | |
| 4 | 7 | | 8 | | | 9 | | 10 | | 11 | | | 12 |
| 5 | | | | | | | | | | | | | |
| 6 | 18 | | 17 | | | 16 | | 15 | | 14 | | | 13 |
| 7 | | | | | | | | | | | | | |
| 8 | 19 | | 20 | | | 21 | | 22 | | 23 | | | 24 |
| 9 | | | | | | | | | | | | | |
| 10 | 30 | | 29 | | | 28 | | 27 | | 26 | | | 25 |
| 11 | | | | | | | | | | | | | |
| 12 | 31 | | 32 | | | 33 | | 34 | | 35 | | | 36 |
| 13 | | | | | | | | | | | | | |

A. Description of original monument and accessories and/or subsequent restoration:
1817 G.L.O. Wampler D.S. Set Post


There are two L.C.R.C.'s

- 1) 1987 P.S. #22445 L.9840, Pg.343 Found P.K. Nail
- *2) 1996 P.S. #33136 L.16446, Pg.102 Found iron in mon. box.

B. Description of corner evidence found and/or method applied in restoring or reestablishing corner:

Found $\frac{1}{2}$ " iron in mon. box at the intersection of Walton Blvd. and Giddings Road. Validated corner by recovered witnesses in the above L.C.R.C. #2 and by monumentation recovered in "Chief Pontiac Farms" L.51, Pg.47, and "A.P. No. 146" L.35, Pg.41.

State Plane Coordinate N 431227.7231
E 13420620.2164

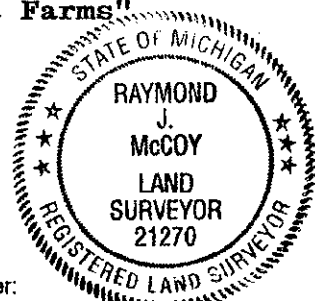

C. Description of monument for corner and accessories established to perpetuate locating the position of the corner:

Accepted and replaced found $\frac{1}{2}$ " iron in mon. box with a 5/8"x24" iron rod w/2" dia. brass disk stamped "Oakland County Remonumentation P.S. #21270."

Witnesses:

- N10°W 184.66' Set O.C.R.T. #21270 in E face of P.P.
- N31°E 127.72' Set O.C.R.T. #21270 in W face of Twin 12" Elm.
- S36°E 84.30' Set O.C.R.T. #21270 in NE face of 10" Maple.
- S16°W 62.90' Set O.C.R.T. #21270 in E face of P.P.

The selected location is accepted by me and is generally accepted by Professional Surveyors as the best available evidence of the position of the original corner.

Signed by Raymond J. McCoy
Surveyor's Michigan License No. 21270

Date 2-19-99