

LAND CORNER RECORDATION CERTIFICATE

Filing Requirement of Act 74, Mich. P.A. 1970 31114

For corners in

Oakland

(County)

Pontiac

Located in: Twp. Corner Code # H-9

LIBER 21052 PAGE 166
\$7.00 MISC RECORDING
\$2.00 REMONUMENTATION
02/01/2000 09:59:02 A.M. RECEIPT# 7944
PAID RECORDED - OAKLAND COUNTY
G. WILLIAM CADDELL, CLERK/REGISTER OF DEEDS

1. Public Land Survey

T 3NR 10E H-9

2. Property Controlling in Section

S T R

3. Miscellaneous Property in Sec.

S T R
S T R
S T R

SURVEY &
RECORDATION

MAR 21 2000

Register of Deeds Stamp & File Number

4. Lot No. Recorded Plat

5. Private Claims

SECTION

Raymond J. McCoy

June 3 99


I, Raymond J. McCoy, in a field survey on June 3, 1999 do hereby state that under requirements of P.A. 74, Michigan P.A. of 1970, the corner points mentioned in lines 1 and 2 above were in conformance with regulations and rules therefore as required in the current manual of survey instructions of the United States Department of the Interior, Bureau of Land Management or by a decree of a Court of Law and/or that the corner points mentioned in lines 3, 4 and 5 above were in conformance with the rules of the Michigan Board of Land Surveyors or by a Decree of a Court of Law; established, re-established, monumented, recovered, found as expressed below.

NOTE: Not more than 2 corners, all in the same town and range, may be recorded on this certificate.

Grid table with columns A-K and rows 1-13. A dot is marked at the intersection of column H and row 10.

A. Description of original monument and accessories and/or subsequent restoration:

1817 Post, GLO
There are no LCRC's recorded.

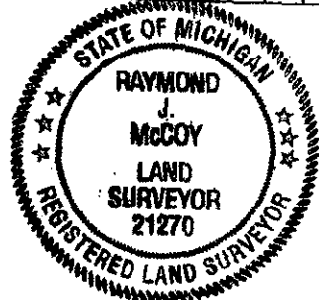

B. Description of corner evidence found and/or method applied in restoring or reestablishing corner:

No corner was found. Corner was established by using monumentation found in "PLEASANT DALE SUBDIVISION", more particularly irons found along the Northerly R/W line of Featherstone Road.

State Plane Coordinates N 420650.5193
E 13421106.9355

C. Description of monument for corner and accessories established to perpetuate locating the position of the corner:

Set a 5/8"x24" iron rod with a 2" diameter brass disk stamped Oakland County Remonumentation P.S. #21270 in a new Monument Box.

Witnesses:

- N 30° E, 34.21', Set OCRT in W. face of GHardrail post.
South, 34.16' Set OCRT in W. face of Guardrail post.
S 50° W, 93.86' NE top C/L bolt of Metal Traffic Support Pole
N 45° W, 79.13 Set OCRT in SW 12" Maple

THE SELECTED LOCATION IS ACCEPTED BY ME AND IS GENERALLY ACCEPTED BY PROFESSIONAL SURVEYORS AS THE BEST AVAILABLE EVIDENCE OF THE POSITION OF THE ORIGINAL CORNER.

Signed by Raymond J. McCoy
Surveyor's Michigan License No. 21270

Date 1-5-00