

MAY 24 2000

LIBER 19827 PAGE 743

126747

SECTION

LAND CORNER RECORDATION CERTIFICATE
Filing Requirement of Act 74, Mich. P.A. 1970

LIBER 19827 PAGE 743
\$9.00 MISC RECORDING
\$2.00 REMONUMENTATION
04/13/1999 01:46:10 P.M. RECEIPT #
PAID RECORDED - OAKLAND COUNTY
G. WILLIAM CADDELL, CLERK/REGISTER

For corners in

Oakland
(County)

Located in: Pontiac Corner Code #
Twp.

- 1. Public Land Survey T 3NR 10E I-3
T R
T R
T R
- 2. Property Controlling in Section S T R
S T R
- 3. Miscellaneous Property in Sec. S T R
S T R

Compliance with ACT 345, P.A. 1990
APPROVED ON: 3-18-99 JS
OAKLAND COUNTY REMONUMENTATION PEER GROUP COMMITTEE
Register of Deeds Stamp & File Number

4. Lot No. _____, Recorded Plat _____
5. Private Claims _____

Raymond J. McCoy in a field survey on FEB. 8, 1999 do hereby state that under requirements of P.A. 74, Michigan P.A. of 1970, the corner points mentioned in lines 1 and 2 above were in conformance with regulations and rules therefore as required in the current manual of survey instructions of the United States Department of the Interior, Bureau of Land Management or by a decree of a Court of Law and/or that the corner points mentioned in lines 3, 4 and 5 above were in conformance with the rules of the Michigan Board of Land Surveyors or by a Decree of a Court of Law, established, re-established, monumented, recovered, found as expressed below:


NOTE: Not more than 2 corners, all in the same town and range, may be recorded on this certificate.

	A	B	C	D	E	F	G	H	I	J	K	L
1												
2	6		5		4		3		2			
3												
4	7		8		9		10		11		12	
5												
6	18		17		16		15		14		13	
7												
8	19		20		21		22		23		24	
9												
10	30		29		28		27		26		25	
11												
12	31		32		33		34		35		36	
13												

A. Description of original monument and accessories and/or subsequent restoration:

Wampler, D.S., Set Post
1 L.C.R.C.

1) 1972-Tredinnick, Set 1" iron in Median of I-75. No witnesses

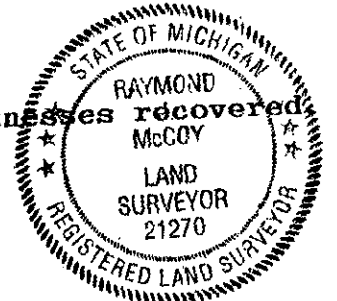

B. Description of corner evidence found and/or method applied in restoring or reestablishing corner:
Established corner from Survey by Nowak & Fraus (Job No. 947893-1) meaasuring Southerly from the West 1/4 corner through the found capped iron at the R/W fence for I-75, the recorded distance of 2678.49 Ft., chiseled a "X" in the concrete shoulder of Northbound Lane, 5.15 Ft. northerly of the concrete barrier. Established reference corners, one on the west line of Sec. 2, 276.35 Ft. North of the corner at the capped iron on the R/W line, and one located on the South line of Section 2, 237.85 Ft. Easterly of the corner located on the R/W line.

State Plane Coordinantes N 436734.1285
E 13423000.4333

C. Description of monument for corner and accessories established to perpetuate locating the position of the corner:
Set concrete Monuments at each Reference Corner, consisting of 1/2" iron rod encased in a 4" diameter concrete cylinder 36" long with a 2" diameter brass disk stamped Oakland County Remonumentation P.S. #21270.

REFERENCE CORNER(NORTH) Replaced Capped iron #12578
N 10° E, 37.31' Chiseled "X" on S. Rim of San. M.H.
S 15° E, 42.13' Set O.C.R.T. #21270 W. face 6" ELM
N 80° W, 12.81' Set O.C.R.T. #21270 N. face 10" Elm
N 30° W, 21.10' Set O.C.R.T. #21270 S.W. face of 12" ELM

STATE PLANE COORDINATES
N 437010.1926
E 13422987.8665

REFERENCE CORNER(EAST)
North, 9.63' Set O.C.R.T. #21270 W. face of 12" ELM
N 30° E, 15.24' Set O.C.R.T. #21270 N.W. face 15" ELM

STATE PLANE COORDINATES
N 436745.6536
E 13423238.0039

Signed by Raymond J. McCoy
Surveyor's Michigan License No. 21270

Date May 22, 99

CONTINUED ON BACK