

LAND CORNER RECORDATION CERTIFICATE
Filing Requirement of Act 74, Mich. P.A. 1970

206144

For corners in

OAKLAND

(County)

PONTIAC

Located in: TWP. Corner Code # I-6

LIBER 20101 PAGE 704
\$7.00 MISC RECORDING
\$2.00 REMONUMENTATION
06/10/1999 12:32:43 P.M. RECEIPT# 41597
PAID RECORDED - OAKLAND COUNTY
G. WILLIAM CADDELL, CLERK/REGISTER OF DEEDS

Compliance with
ACT 345, P.A. 1990

APPROVED ON: 9-4-99 JS
OAKLAND COUNTY REMONUMENTATION
PEER GROUP COMMITTEE

Register of Deeds Stamp & File Number

1. Public Land Survey

T 3NR 10E I-6

T R

T R

T R

S T R

S T R

S T R

S T R

2. Property Controlling
in Section


3. Miscellaneous
Property in Sec.

4. Lot No. _____, Recorded Plat _____
5. Private Claims _____

RAYMOND J. McCOY in a field survey on Feb. 23, 1999 do hereby state that under requirements of P.A. 74, Michigan P.A. of 1970, the corner points mentioned in lines 1 and 2 above were in conformance with regulations and rules therefore as required in the current manual of survey instructions of the United States Department of the Interior, Bureau of Land Management or by a decree of a Court of Law and /or that the corner points mentioned in lines 3, 4 and 5 above were in conformance with the rules of the Michigan Board of Land Surveyors or by a Decree of a Court of Law; established, re-established, monumented, recovered, found as expressed below:

NOTE: Not more than 2 corners, all in the same town and range, may be recorded on this certificate.

| | A | B | C | D | E | F | G | H | I | J | K | L | M |
|----|----|----|----|----|----|----|---|---|---|---|---|---|---|
| 1 | | | | | | | | | | | | | |
| 2 | 6 | 5 | 4 | 3 | 2 | 1 | | | | | | | |
| 3 | | | | | | | | | | | | | |
| 4 | 7 | 8 | 9 | 10 | 11 | 12 | | | | | | | |
| 5 | | | | | | | | | | | | | |
| 6 | 18 | 17 | 16 | 15 | 14 | 13 | | | | | | | |
| 7 | | | | | | | | | | | | | |
| 8 | 19 | 20 | 21 | 22 | 23 | 24 | | | | | | | |
| 9 | | | | | | | | | | | | | |
| 10 | 30 | 29 | 28 | 27 | 26 | 25 | | | | | | | |
| 11 | | | | | | | | | | | | | |
| 12 | 31 | 32 | 33 | 34 | 35 | 36 | | | | | | | |

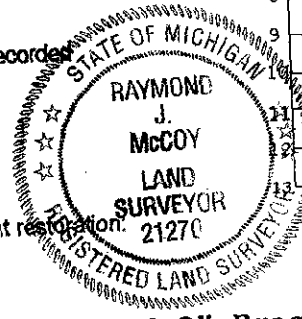

A. Description of original monument and accessories and/or subsequent relocations.

WAMPLER, D.S., SET POST
THERE ARE TWO LCRC'S RECORDED.
1) 1973- G. Stonerock, L. 6212, Pg. 268, Found 2" Brass Plug, 2 witnesses remain.
2) 1983- H. Kennedy, L. 8538, Pg. 730, Found 2" iron, one witness remains.

B. Description of corner evidence found and/or method applied in restoring or reestablishing corner:

Found 2" diameter brass disk centerline of Commonwealth Road, 1 Ft. North of Pontiac Road in a hole under the asphalt. Recovered the corner from the remaining witnesses in the above LCRC'S. Validated corner with monumentation found in "GALLOWAY LAKE FARMS"(L.31, Pg. 2 & 3, 1923), more particularly irons located on the Easterly R/W line of Commonwealth Road lying southerly of Pontiac Road. Also validated corner with measurement to Found Monument Box at the intersection of Pontiac Road & Opdyke Road(1381.85 Meas., 1381.92(Keift,1963), 1381.92 Johnson & Anderson (1991) and with McCoy Surveys (1996 & 1998) fitting acreage parcels in the SE 1/4 of Section 15. In addition, the Road commission witnesses (1952) refer to the corner as a brass plate.

State Plane Coordinates N 428781.1073
E 13423380.6833

C. Description of monument for corner and accessories established to perpetuate locating the position of the corner:

Replaced the found 2" brass disk with a 5/8"x24" iron rod with a 2" diameter brass disk stamped Oakland County Remonumentation P.S. #21270 in a New Monument Box.

Witnesses:
S 35° W, 40.97, Set OCRT #21270 in SE face of Power Pole.
S 45° E, 94.25, Set OCRT #21270 in NE face of 13" Pine
N 35° E, 97.78, Set OCRT #21270 in NW face of 32" ELM
N 37° W, 38.00, Set OCRT #21270 in SW face of Power Pole.

THE SELECTED LOCATION IS ACCEPTED BY ME AND IS GENERALLY ACCEPTED BY PROFESSIONAL SURVEYORS AS THE BEST AVAILABLE EVIDENCE OF THE POSITION OF THE ORIGINAL CORNER.

Signed by Raymond J. McCoy
Surveyor's Michigan License No. 21270

Date May 28, 1999