

LAND CORNER RECORDATION CERTIFICATE
Filing Requirement of Act 74, Mich. P.A. 1970

31116

For corners in

Oakland

(County)

Pontiac

Located In: Twp. Corner Code #

LIBER 21052 PAGE 168
\$7.00 MISC RECORDING
\$2.00 REMONUMENTATION
02/01/2000 09:59:02 A.M. RECEIPT# 7944
PAID RECORDED - OAKLAND COUNTY
G. WILLIAM CADDELL, CLERK/REGISTER OF DEEDS

1. Public Land Survey

T 3N R 10E I-7

T R

T R

T R

S T R

2. Property Controlling in Section

S T R

S T R

3. Miscellaneous Property in Sec.

S T R

S T R

SECTION

4. Lot No. _____, Recorded Plat _____

5. Private Claims _____

Raymond J. McCoy

September 4 99

I, _____, in a field survey on _____, 19____ do hereby state that under requirements of P.A. 74, Michigan P.A. of 1970, the corner points mentioned in lines 1 and 2 above were in conformance with regulations and rules therefore as required in the current manual of survey instructions of the United States Department of the Interior, Bureau of Land Management or by a decree of a Court of Law and /or that the corner points mentioned in lines 3, 4 and 5 above were in conformance with the rules of the Michigan Board of Land Surveyors or by a Decree of a Court of Law; established, re-established, monumented, recovered, found as expressed below:

NOTE: Not more than 2 corners, all in the same town and range, may be recorded on this certificate.

A. Description of original monument and accessories and/or subsequent restoration:

1817 Post GLO
Corner falls in Galloway Lake

B. Description of corner evidence found and/or method applied in restoring or reestablishing corner:

A reference corner was recovered by using witnesses from recorded survey L. 10491, Pg 38(Ray Donnelly). Corner was validated by measuring closely with Donnelly to the South (I-8)

State Plane Coordinates N 425843.6729
E 13423529.3004
(MEANDER CORNER)

C. Description of monument for corner and accessories established to perpetuate locating the position of the corner:

Set a concrete mOnument at the REFERENCE CORNER location, consisting of a 1/2" iron rod encased in a 4" diameter concrete cylinder 36" long with a 2" diameter brass disk stamped Oakland County Remonumentation P.S. #21270.

Witnesses:

N 05° E, 5.28 Set OCRT vertically in a 18" stump
S 05° W, Set OCRT in W. face of 30" Willow
West, 24.21 Set OCRT in S. face of tri 14" Willow
N 50° W, 22.83 Set OCRT in N. face of 16" Willow


THE SELECTED LOCATION IS ACCPETED BY ME AND IS GENERALLY ACCEPTED BY PROFESSIONAL SURVEYORS AS THE BEST AVAILABLE EVIDENCE OF THE POSITION OF

Signed THE ORIGINAL CORNER Date 1-9-00

Surveyor's Michigan License No. 21270

Raymond J. McCoy

A	B	C	D	E	F	G	H	I	J	K	L
1											
2	6	5	4	3	2	1					
3											
4	7	8	9	10	11	12					
5											
6	18	17	16	15	14	13					
7											
8	19	20	21	22	23	24					
9											
10	30	29	28	27	26	25					
11											
12	31	32	33	34	35	36					
13											

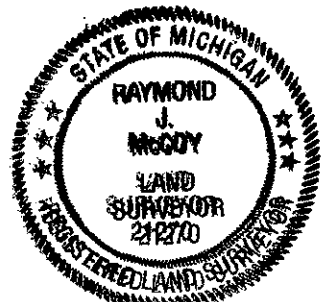

lp
R