

SURVEY & REMONUMENTATION

MAY 24 2000

LIBER 19629PG340

SECTION

LAND CORNER RECORDATION CERTIFICATE  
Filing Requirement of Act 74, Mich. P.A. 1970

7171E

For corners in

|                                    |   |             |
|------------------------------------|---|-------------|
| <u>Oakland</u><br>(County)         | Located in, <u>Pontiac</u> Corner Code #<br><u>Twp.</u> |             |
| 1. Public Land Survey              | T <u>3N</u> R <u>10E</u>                                | <u>I-13</u> |
|                                    | T ___ R ___   | _____       |
|                                    | T ___ R ___   | _____       |
|                                    | T ___ R ___   | _____       |
| 2. Property Controlling in Section | S ___ T ___ R ___                                       | _____       |
|                                    | S ___ T ___ R ___                                       | _____       |
| 3. Miscellaneous Property in Sec.  | S ___ T ___ R ___                                       | _____       |
|                                    | S ___ T ___ R ___                                       | _____       |

\$7.00 MISC RECORDING  
\$2.00 REMONUMENTATION  
03/03/1999 03:32:14 P.M. RECEIPT# 4986  
PAID RECORDED - OAKLAND COUNTY  
G. WILLIAM CADDELL, CLERK/REGISTER OF DEEDS

Compliance with  
ACT 345, P.A. 1990

APPROVED ON: 1-13-99 JS  
OAKLAND COUNTY REMONUMENTATION  
PEER GROUP COMMITTEE

Register of Deeds Stamp & File Number

4. Lot No. \_\_\_\_\_, Recorded Plat \_\_\_\_\_  
5. Private Claims \_\_\_\_\_

I, Raymond J. McCoy in a field survey on Dec. 7, 1998 do hereby state that under requirements of P.A. 74, Michigan P.A. of 1970, the corner points mentioned in lines 1 and 2 above were in conformance with regulations and rules therefore as required in the current manual of survey instructions of the United States Department of the Interior, Bureau of Land Management or by a decree of a Court of Law and/or that the corner points mentioned in lines 3, 4 and 5 above were in conformance with the rules of the Michigan Board of Land Surveyors or by a Decree of a Court of Law; established, re-established, monumented, recovered, found as expressed below:

NOTE: Not more than 2 corners, all in the same town and range, may be recorded on this certificate.

|    | A  | B | C  | D | E  | F | G  | H | I  | J | K  | L |
|----|----|---|----|---|----|---|----|---|----|---|----|---|
| 1  |    |   |    |   |    |   |    |   |    |   |    |   |
| 2  | 6  |   | 5  |   | 4  |   | 3  |   | 2  |   | 1  |   |
| 3  |    |   |    |   |    |   |    |   |    |   |    |   |
| 4  | 7  |   | 8  |   | 9  |   | 10 |   | 11 |   | 12 |   |
| 5  |    |   |    |   |    |   |    |   |    |   |    |   |
| 6  | 18 |   | 17 |   | 16 |   | 15 |   | 14 |   | 13 |   |
| 7  |    |   |    |   |    |   |    |   |    |   |    |   |
| 8  | 19 |   | 20 |   | 21 |   | 22 |   | 23 |   | 24 |   |
| 9  |    |   |    |   |    |   |    |   |    |   |    |   |
| 10 | 30 |   | 29 |   | 28 |   | 27 |   | 26 |   | 25 |   |
| 11 |    |   |    |   |    |   |    |   |    |   |    |   |
| 12 | 31 |   | 32 |   | 33 |   | 34 |   | 35 |   | 36 |   |
| 13 |    |   |    |   |    |   |    |   |    |   |    |   |

A. Description of original monument and accessories and/or subsequent restoration:  
1817 G.L.O. Wampler D.S. Set post

- \*1) 1971 P.S. #16390 L.5790, Pg.517 Found P.K. nail in pavement.
- \*2) 1987 P.S. #22445 L.9840, Pg.339 Found large spike.

B. Description of corner evidence found and/or method applied in restoring or reestablishing corner:  
Found P.K. nail in asphalt pavement 1.7' South of empty monument box, 34'± West of the centerline of Opdyke Rd. in the centerline of South Blvd. Validated corner by recovered witnesses on the enclosed L.C.R.C.'s and by recorded survey L.5790, Pg.521. Replaced found P.K. nail with a 5/8"x24" iron rod w/2" diameter brass disk stamped Oakland County Remonumentation P.S. #21270 in a new monument box. (Removed existing Northerly box)

State Plane Coordinate N 410128.1882  
E 1342450.1050


IP  
R

C. Description of monument for corner and accessories established to perpetuate locating the position of the corner:  
Replaced found P.K. nail with a 5/8"x24" iron rod w/2" diameter brass disk stamped Oakland County Remonumentation P.S. #21270 in a new mon. box.

- Witnesses:
- N30°W 64.58' Set O.C.R.T. #21270 in SW face of P.P.
  - S80°E 193.18' Set O.C.R.T. #21270 in N face of P.P.
  - S30°E 57.11' Set O.C.R.T. #21270 in NW face of P.P.
  - S70°W 161.83' Set O.C.R.T. #21270 in N face of P.P.
  - \*N87°E 34.03' Monument box (I-1) Bloomfield.

The selected location is accepted by me and is generally accepted by Professional Surveyors as the best available evidence of the position of the original corner.

Signed by Raymond J. McCoy  
Surveyor's Michigan License No. 21270

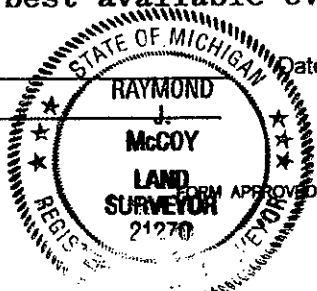

Date Jan 21 1999