

LAND CORNER RECORDATION CERTIFICATE  
Filing Requirement of Act 74, Mich. P.A. 1970 31123

For corners in

Oakland

(County)

Pontiac

Located in: Twp. Corner Code #

LIBER 21052 PAGE 175

\$7.00 MISC RECORDING

\$2.00 REMONUMENTATION

02/01/2000 09:59:20 A.M. RECEIPT# 7944

PAID RECORDED - OAKLAND COUNTY

G. WILLIAM CADDELL, CLERK/REGISTER OF DEEDS

1. Public Land Survey

T 3NR 10E

J-9

T R

T R

T R

T R

T R

T R

T R

2. Property Controlling in Section

S

T R

S

T R

S

T R

S

T R

3. Miscellaneous Property in Sec.

4. Lot No. \_\_\_\_\_, Recorded Plat \_\_\_\_\_

5. Private Claims \_\_\_\_\_


Raymond J. McCoy

September 5 99

I, \_\_\_\_\_, in a field survey on \_\_\_\_\_, 19\_\_\_\_ do hereby state that under requirements of P.A. 74, Michigan P.A. of 1970, the corner points mentioned in lines 1 and 2 above were in conformance with regulations and rules therefore as required in the current manual of survey instructions of the United States Department of the Interior, Bureau of Land Management or by a decree of a Court of Law and/or that the corner points mentioned in lines 3, 4 and 5 above were in conformance with the rules of the Michigan Board of Land Surveyors or by a Decree of a Court of Law; established, re-established, monumented, recovered, found as expressed below:

NOTE: Not more than 2 corners, all in the same town and range, may be recorded on this certificate.

	A	B	C	D	E	F	G	H	I	J	K	L	M
1													
2	6		5		4		3		2		1		
3													
4	7		8		9		10		11		12		
5													
6	18		17		16		15		14		13		
7													
8	19		20		21		22		23		24		
9													
10							28		27		26		25
11													
12							32		33		34		35
13													
14													
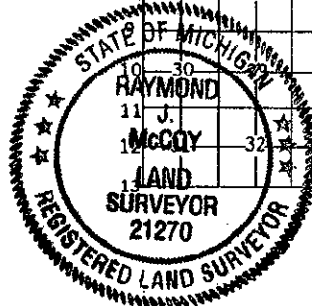

A. Description of original monument and accessories and/or subsequent restoration:

1817 Post, GLO

There are 2 LCRC's recorded.

- 1) 1986 Erickson, L. 9905, Pg. 507, 1 1/2" iron in Mon. Box. No witnesses left
- 2) 1992-Fraus, L. 12487, Pg. 264, Set chiseled "x", 2 remaining witnesses.

B. Description of corner evidence found and/or method applied in restoring or reestablishing corner:

Found chiseled "x" on Bridge for I-75, 8ft South of centerline of Westbound Featherstone Road. Recovered corner from the remaining witnesses in LCRC #2 above and remaining witnesses in various recorded Surveys. Validated corner by measuring closely to the recorded surveys to I-9 & K-9.

State Plane Coordinates N 420906.17  
E 13426737.20

C. Description of monument for corner and accessories established to perpetuate locating the position of the corner:

Replaced chiseled "x" with a 2" diameter brass disk stamped Oakland County Remonumentation P.S. #21270 in the concrete pavement of Featherstone Road.

Witnesses:

- S 73° W, 35.07', Found nail/washer on barrier wall for Bridge
- S 56° E, 14.96' " " " "
- N 48° E, 39.34' " " " "
- N 32° W, 28.83' " " " "

THE SELECTED LOCATION IS ACCPETED BY ME AND IS GENERALLY ACCEPTED BY PROFESSIONAL SURVEYORS AS THE BEST AVAILABLE EVIDENCE OF THE POSITION OF THE ORIGINAL CORNER.

Signed by \_\_\_\_\_ Date 1-5-00

Surveyor's Michigan License No. 21270

*Raymond J. McCoy*