

LAND CORNER RECORDATION CERTIFICATE  
Filing Requirement of Act 74, Mich. P.A. 1970

For corners in

OAKLAND

(County)

PONTIAC

Located In: TWP. Corner Code # J-11

206146

LIBER 20101 PAGE 706  
\$7.00 MISC RECORDING  
\$2.00 REMONUMENTATION  
06/10/1999 12:32:43 P.M. RECEIPT# 41597  
PAID RECORDED - OAKLAND COUNTY  
G. WILLIAM CADDELL, CLERK/REGISTER OF DEEDS  
Compliance with  
ACT 345, P.A. 1990

APPROVED ON: 5-26-99 JS  
OAKLAND COUNTY REMONUMENTATION  
PEER GROUP COMMITTEE

Register of Deeds Stamp & File Number


1. Public Land Survey T 3N R 10E J-11  
T \_\_\_ R \_\_\_  
T \_\_\_ R \_\_\_  
T \_\_\_ R \_\_\_  
T \_\_\_ R \_\_\_  
2. Property Controlling S \_\_\_ T \_\_\_ R \_\_\_  
in Section S \_\_\_ T \_\_\_ R \_\_\_  
3. Miscellaneous S \_\_\_ T \_\_\_ R \_\_\_  
Property in Sec. S \_\_\_ T \_\_\_ R \_\_\_

4. Lot No. \_\_\_\_\_, Recorded Plat \_\_\_\_\_  
5. Private Claims \_\_\_\_\_

RAYMOND J. McCOY May 5 99

I, \_\_\_\_\_, in a field survey on \_\_\_\_\_, 19\_\_\_\_ do hereby state that under requirements of P.A. 74, Michigan P.A. of 1970, the corner points mentioned in lines 1 and 2 above were in conformance with regulations and rules therefore as required in the current manual of survey instructions of the United States Department of the Interior, Bureau of Land Management or by a decree of a Court of Law and/or that the corner points mentioned in lines 3, 4 and 5 above were in conformance with the rules of the Michigan Board of Land Surveyors or by a Decree of a Court of Law; established, re-established, monumented, recovered, found as expressed below:

NOTE: Not more than 2 corners, all in the same town and range, may be recorded on this certificate.

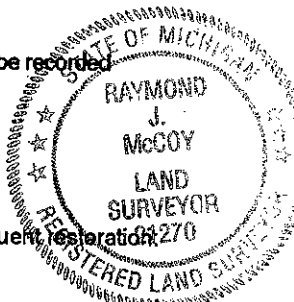

	A	B	C	D	E	F	G	H	I	J	K	L	M
1													
2		6		5		4		3		2		1	
3													
4		7		8		9		10		11		12	
5													
6		18		17		16		15		14		13	
7													
8		19		20		21		22		23		24	
9													
10		30		29		28		27		26		25	
11													
12		31		32		33		34		35		36	
13													

A. Description of original monument and accessories and/or subsequent restoration:

WAMPLER, D.S., SET POST  
THERE ARE TWO LCRC'S RECORDED.  
1) 1986- J. ERICKSON (L. 9905, Pg. 508, Found 3/8" iron, east edge of two-track One remaining witness.  
2) 1993-G. Stonerock, (L. 13326, Pg. 188), Found 3/4" pipe in concrete monument on a N-S treeline. 3 remaining witnesses. (WITNESSED R/W MONUMENT)

B. Description of corner evidence found and/or method applied in restoring or reestablishing corner:

Found concrete monument with 3/8" rod in a 1" pipe, centerline of two-track Doris Road, approx. 300' +/- North of Auburn Ave., 45 feet Westerly of West Right-Of-Way fence of I-75 Expressway. Recovered corner from the remaining witness of LCRC #1 above. Validated corner with the found Right-Of-Way monument as referenced in "SUPERVISOR'S PLAT NO. 11". Also validated corner with measuring closely to the platted distance Easterly to K-11(3093.18 Meas., GPS, 3093.72 Plat).

State Plane Coordinates N 415860.9378  
E 13426683.0481

C. Description of monument for corner and accessories established to perpetuate locating the position of the corner:

Affixed a 2" diameter brass disk stamped Oakland County Remonumentation P.S. #21270 on the existing monument.

Witnesses:

N 14° E, 43.14' Set OCRT #21270 in W. face of 12" Oak  
East, 22.53', Set OCRT #21270 in South face of 12" Oak  
S 84° E, 33.58' to Found Concrete Monument.  
S 68° W, 22.67', Set OCRT #21270 in North face 22" Oak

THE SELECTED LOCATION IS ACCEPTED BY ME AND IS GENERALLY ACCEPTED BY PROFESSIONAL SURVEYORS AS THE BEST AVAILABLE EVIDENCE OF THE POSITION OF THE ORIGINAL CORNER.

Signed by Raymond J. McCoy  
Surveyor's Michigan License No. 21270

Date May 27, 1999