

LIBER 19629PC343

LAND CORNER RECORDATION CERTIFICATE
Filing Requirement of Act 74, Mich. P.A. 1970

71719

For corners in

Oakland
(County)

Located in: Pontiac Corner Code #
Twp.

47.00 MISC RECORDING
\$2.00 REMONUMENTATION
03/03/1999 03:32:14 P.M. RECEIPT# 4986
PAID RECORDED - OAKLAND COUNTY
G. WILLIAM CADDELL, CLERK/REGISTER OF DEEDS

1. Public Land Survey

T 3N R 10E K-1

T ___ R ___
T ___ R ___
T ___ R ___

2. Property Controlling in Section

S ___ T ___ R ___
S ___ T ___ R ___

3. Miscellaneous Property in Sec.

S ___ T ___ R ___
S ___ T ___ R ___

Compliance with
ACT 345, P.A. 1990

APPROVED ON: 12-17-98 53
OAKLAND COUNTY REMONUMENTATION
PEER GROUP COMMITTEE

Register of Deeds Stamp & File Number

4. Lot No. _____, Recorded Plat _____
5. Private Claims _____

Raymond J. McCoy in a field survey on Dec. 2, 1998 do hereby state that under requirements of P.A. 74, Michigan P.A. of 1970, the corner points mentioned in lines 1 and 2 above were in conformance with regulations and rules therefore as required in the current manual of survey instructions of the United States Department of the Interior, Bureau of Land Management or by a decree of a Court of Law and/or that the corner points mentioned in lines 3, 4 and 5 above were in conformance with the rules of the Michigan Board of Land Surveyors or by a Decree of a Court of Law; established, re-established, monumented, recovered, found as expressed below:

	A	B	C	D	E	F	G	H	I	J	K	L
1												
2		6		5		4		3		2		
3												
4		7		8		9		10		11		1
5												
6		18		17		16		15		14		1
7												
8		19		20		21		22		23		2
9												
10		30		29		28		27		26		2
11												
12		31		32		33		34		35		3
13												

NOTE: Not more than 2 corners, all in the same town and range, may be recorded on this certificate.

A. Description of original monument and accessories and/or subsequent restoration:
1817 G.L.O. Wampler D.S. Set post

*1) 1995 P.S. #17623 Found $\frac{1}{2}$ " iron rod and replaced it with $\frac{5}{8}$ "x24" iron rod with a 2" diameter brass disk stamped Oakland County Remonumentation P.S. #17623. Corner is common to K-13 (Orion).

B. Description of corner evidence found and/or method applied in restoring or reestablishing corner:
Found 2" dia. brass disk stamped Oakland County Remonumentation P.S. #1762; at the intersections of Dutton and Bald Mt. Roads. (gravel)

Validated corner by L.C.R.C. #1 and by points found along the Westerly R.O.W. of Bald Mt. Rd.


State Plane Coordinate N 442649.3737
E 13428137.0300

C. Description of monument for corner and accessories established to perpetuate locating the position of the corner:
Found and accepted 2" dia. brass disk as to be the best position of the original corner in regard to evidence found.

Witnesses:
N38°W 46.55' Found O.C.R.T. #17623 in NE face of 27" Oak.
N47°E 71.71' Found O.C.R.T. #17623 in NW face of P.P.
S40°W 38.03' Found O.C.R.T. #17623 in SE face of 10" Oak.
S46°E 77.69' Found O.C.R.T. #17623 in NE face of Guide Pole.

The selected location is accepted by me and is generally accepted by Professional Surveyors as the best available evidence of the position of the original corner.

Signed by Raymond J. McCoy
Surveyor's Michigan License No. 21270

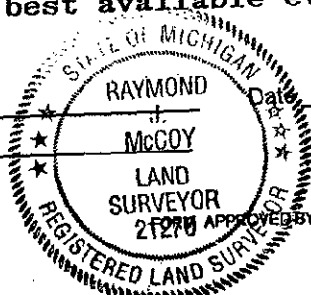

Jan 21 1999