

LIBER 19629PG344

LAND CORNER RECORDATION CERTIFICATE  
Filing Requirement of Act 74, Mich. P.A. 1970

71720

For corners in

Oakland  
(County)

Located In: Pontiac Corner Code #  
Twp.

\$7.00 NISC RECORDING  
\$2.00 REMONUMENTATION  
03/03/1999 03:32:14 P.M. RECEIPT# 4986  
PAID RECORDED - OAKLAND COUNTY  
G. WILLIAM CADDELL, CLERK/REGISTER OF DEEDS

Compliance with  
ACT 345, P.A. 1990

APPROVED ON: 12-17-98 JS  
OAKLAND COUNTY REMONUMENTATION  
PEER GROUP COMMITTEE

Register of Deeds Stamp & File Number

1. Public Land Survey

T 3N R 10E K-3

T      R          

T      R          

T      R          

2. Property Controlling  
in Section

S      T      R     

S      T      R     

3. Miscellaneous  
Property in Sec.

S      T      R     

S      T      R     

SURVEY &  
RECORDATION

MAR 21 2000

SECTION

4. Lot No. \_\_\_\_\_, Recorded Plat \_\_\_\_\_  
5. Private Claims \_\_\_\_\_

	A	B	C	D	E	F	G	H	I	J	K	L
1												
2		5		5				3			2	1
3												
4		7		8		9		10		11		12
5												
6		18		17		16		15		14		13
7												
8		19		20		21		22		23		24
9												
10		30		29		28		27		26		25
11												
12		31		32		33		34		35		36
13												

I, Raymond J. McCoy a field surveyor on Dec. 2, 1998 do hereby state that under requirements of P.A. 74, Michigan P.A. of 1970, the corner points mentioned in lines 1 and 2 above were in conformance with regulations and rules therefore as required in the current manual of survey instructions of the United States Department of the Interior, Bureau of Land Management or by a decree of a Court of Law and/or that the corner points mentioned in lines 3, 4 and 5 above were in conformance with the rules of the Michigan Board of Land Surveyors or by a Decree of a Court of Law; established, re-established, monumented, recovered, found as expressed below:

NOTE: Not more than 2 corners, all in the same town and range, may be recorded on this certificate.

A. Description of original monument and accessories and/or subsequent restoration:

- 1817- G.L.O. Wampler D.S.; Set post
- \*1) 1984 P.S.# 17623 L.8779, Pg.762 found concrete monument.
- \*2) 1992 P.S.# 28422 L.13355, Pg.476 found concrete monument.
- \*3) 1995 P.S.# 33988 L.15237, Pg.227 found concrete monument.
- \*4) 1995 P.S.# 33136 (recorded survey) L.15592, Pg.546.

B. Description of corner evidence found and/or method applied in restoring or reestablishing corner:  
Found concrete monument 300'± South of Bald Mt. Rd. & 5.6' West of 4' woven wire fence.


Validated corner by recorded survey & recovered witnesses in the L.C.R.C.'s above and monumentation in S.P.#12 L.30, Pg.48.

C. Description of monument for corner and accessories established to perpetuate locating the position of the corner:  
Accepted found concrete monument and placed 2" diameter brass disk stamped Oakland County Remonumentation P.S.# 21270 on monument.


Witnesses:

- NO7°E 43.04' Set O.C.R.T.# 21270 in W face of 10" Swamp Oak.
  - S46°E 21.84' Set O.C.R.T.# 21270 in SW face of 30" Swamp Oak.
  - S13°E 12.63' Set O.C.R.T.# 21270 in W face of 32" Swamp Oak.
  - S60°W 12.52' Set O.C.R.T.# 21270 in SE face of 14" Swamp Oak.
- State Plane Coordinate N 436987.5631  
E 13428501.1128

Signed by: Raymond J. McCoy  
Surveyor's Michigan License No. 21270

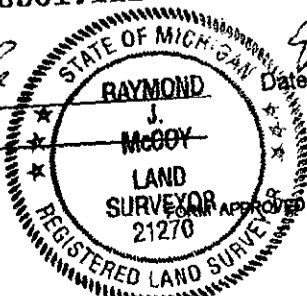

Jan 21, 99  
Date 12-2-98

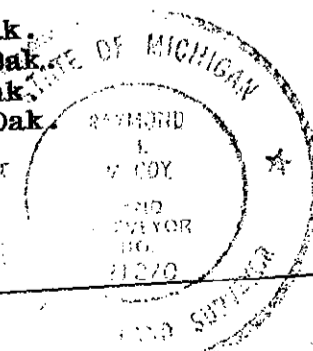

APPROVED BY MICHIGAN STATE BOARD OF PROFESSIONAL SURVEYORS, JAN. 28, 1999  
REVISED MAY 14, 1999  
REVISED JAN. 1999  
REVISED OCT., 1998