

LAND CORNER RECORDATION CERTIFICATE  
Filing Requirement of Act 74, Mich. P.A. 1970

31126

For corners in  
Oakland  
(County)

Pontiac  
Located In: Twp. Corner Code #

LIBER 21052 PAGE 178  
\$7.00 MISC RECORDING  
\$2.00 REMONUMENTATION  
02/01/2000 09:59:20 A.M. RECEIPT# 7944  
PAID RECORDED - OAKLAND COUNTY  
G. WILLIAM CADDELL, CLERK/REGISTER OF DEEDS

APR 11 1999

11-3-99 JIL

Register of Deeds Stamp & Fil: Nu

1. Public Land Survey T 3NR10E K-8  
T R  
T R  
T R  
2. Property Controlling S T R  
in Section S T R  
3. Miscellaneous S T R  
Property in Sec. S T R

SURVEY &  
RECORDATION  
FEB 21 2000

4. Lot No. \_\_\_\_\_, Recorded Plat \_\_\_\_\_ SECTION \_\_\_\_\_  
5. Private Claims \_\_\_\_\_

Raymond J. McCoy Oct. 22 99


I, \_\_\_\_\_, in a field survey on \_\_\_\_\_, 19\_\_\_\_ do hereby state that under requirements of P.A. 74, Michigan P.A. of 1970, the corner points mentioned in lines 1 and 2 above were in conformance with regulations and rules therefore as required in the current manual of survey instructions of the United States Department of the Interior, Bureau of Land Management or by a decree of a Court of Law and for that the corner points mentioned in lines 3, 4 and 5 above were in conformance with the rules of the Michigan Board of Land Surveyors or by a Decree of a Court of Law; established, re-established, monumented, recovered, found as expressed below:

NOTE: Not more than 2 corners, all in the same town and range, may be recorded on this certificate.

	A	B	C	D	E	F	G	H	I	J	K
1											
2	6		5		4		3		2		
3											
4	7		8		9		10		11		
5											
6	18		17		16		15		14		
7											
8	19		20		21		22		23		
9											
10	30		29		28		27		26		
11											
12	31		32		33		34		35		
13											

A. Description of original monument and accessories and/or subsequent restoration:

1817 Post GLO  
There are no LCRC's recorded.

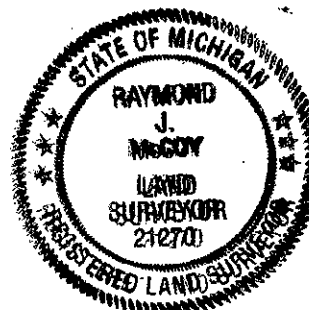

B. Description of corner evidence found and/or method applied in restoring or reestablishing corner:

No corner was found. Corner was estashblished half-way on line between K-7 & K-9.

State Plane Coordinates N 423704.1276  
E 13429245.066

10  
R

C. Description of monument for corner and accessories established to perpetuate locating the position of the corner:

Set concrete monument consisting of a 1/2" iron rod encased in a 4" diameter concrete cylinder 36" long with a 2" diameter brass disk stamped Oakland County Remonumentation P.S. #21270.

Witnesses:

South, 20.14' Set chiseled "x" on concrete slab @ buildijng  
S 60° E, 11.89' Top N. bolt on Post Indicator Valve.  
N 40° E, 22.67 Set chiseled "x" top of curb.  
North, 30.44 Set chiseled "x" on top of curb.

THE SELECTED LOCATION IS ACCEPTED BY ME AND SI GENERALLY ACCPETED BY PROFESSIONAL SURVEYORS AS THE BEST AVAILABLE EVIDENCE OF THE POSITION OF THE ORIGINAL CORNER.

Signed by Raymond J. McCoy  
Surveyor's Michigan License No. 21270

Date 12-5-00