

LAND CORNER RECORDATION CERTIFICATE
Filing Requirement of Act 74, Mich. P.A. 1970

For corners in

OAKLAND

(County)

PONTIAC

Located In: TWP. Corner Code # K-10

206147

LIBER 20101 PAGE 707
\$7.00 MISC RECORDING
\$2.00 REMONUMENTATION
06/10/1999 12:32:43 P.M. RECEIPT# 4155
PAID RECORDED - OAKLAND COUNTY
G. WILLIAM CADDELL, CLERK/REGISTER OF DEEDS

Compliance with
ACT 345, P.A. 1990

APPROVED ON: 5-26-99 JS
OAKLAND COUNTY REMONUMENTATION
PEER GROUP COMMITTEE

Register of Deeds Stamp & File Number

1. Public Land Survey	T	<u>3N</u>	R	<u>10E</u>	<u>K-10</u>
	T	_____	R	_____	_____
	T	_____	R	_____	_____
	T	_____	R	_____	_____
2. Property Controlling in Section	S	_____	T	_____	_____
	S	_____	T	_____	_____
3. Miscellaneous Property in Sec.	S	_____	T	_____	_____
	S	_____	T	_____	_____

4. Lot No. _____, Recorded Plat _____
5. Private Claims _____

RAYMOND J. McCOY May 5 99

I, _____, in a field survey on _____, 19____ do hereby state that under requirements of P.A. 74, Michigan P.A. of 1970, the corner points mentioned in lines 1 and 2 above were in conformance with regulations and rules therefore as required in the current manual of survey instructions of the United States Department of the Interior, Bureau of Land Management or by a decree of a Court of Law and/or that the corner points mentioned in lines 3, 4 and 5 above were in conformance with the rules of the Michigan Board of Land Surveyors or by a Decree of a Court of Law; established, re-established, monumented, recovered, found as expressed below:


NOTE: Not more than 2 corners, all in the same town and range, may be recorded on this certificate.

1	A	B	C	D	E	F	G	H	I	J	K	L
2		6		5		4		3		2		1
3												
4		7		8		9		10		11		12
5												
6		10		17		16		15		14		13
7												
8		19		20		21		22		23		24
9												
10		30		29		28		27		26		25
11												
12		31		32		33		34		35		36
13												

A. Description of original monument and accessories and/or subsequent restoration:

WAMPLER, D.S., SET POST
THERE IS ONE LCRC RECORDED.

* 1) 1994, J. SCHARL, L. 14936, Pg. 254, Found 1/2" rerod.

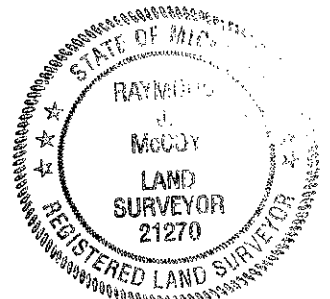

B. Description of corner evidence found and/or method applied in restoring or reestablishing corner:

Corner was located using the witnesses from the above LCRC. Corner was validated using found monumentation in "YOKEYS SUBDIVISION"(L.84, Pg. 32 & 33, 1956). Corner was further validated by matching one remaining witness from a survey by C. Newman(Tri-County Surveys, Job No. 84-71a, 1984).

State Plane Coordinates N 417795.5325
E 13429540.3683

C. Description of monument for corner and accessories established to perpetuate locating the position of the corner:

Set a concrete monument consisting of a 1/2" iron rod encased in a 4" diameter concrete cylinder 36" long with a 2" diameter brass disk stamped Oakland County Remonumentation P.S. #21270 in place of the 1/2" rod.

Witnesses:

- S 80° E, 38.05', Set OCRT #21270 in South face of Power Pole.
- N 15° E, 32.46', Set OCRT #21270 in West face of 22" Cottonwood.
- Due West, 13.28', Set OCRT #21270 in South face of 8" Cottonwood.
- S 50° W, 29.39', Set OCRT #21270 in North face 8" Poplar.

THE SELECTED LOCATION IS ACCEPTED BY ME AND IS GENERALLY ACCEPTED BY PROFESSIONAL SURVEYORS AS THE BEST AVAILABLE EVIDENCE OF THE POSITION OF THE ORIGINAL CORNER.

Signed by Raymond J. McCoy

Date May 28, 1999

Surveyor's Michigan License No. 21270