

LAND CORNER RECORDATION CERTIFICATE  
Filing Requirement of Act 74, Mich. P.A. 1970

206148

For corners in

OAKLAND  
(County)

PONTIAC

Located In: TWP. Corner Code # K-11

LIBER 20101 PAGE 708  
\$7.00 MISC RECORDING  
\$2.00 REMONUMENTATION  
06/10/1999 12:32:43 P.M. RECEIPT# 4159  
PAID RECORDED - OAKLAND COUNTY  
G. WILLIAM CADDELL, CLERK/REGISTER OF DEEDS

Compliance with  
ACT 345, P.A. 1990

APPROVED ON: 5-26-99 JS  
OAKLAND COUNTY REMONUMENTATION  
PEER GROUP COMMITTEE


Register of Deeds Stamp & File Number

1. Public Land Survey	T	<u>3NR</u>	<u>10E</u>	<u>K-11</u>
	T	_____	_____	_____
	T	_____	_____	_____
	T	_____	_____	_____
2. Property Controlling in Section	S	_____	_____	_____
	S	_____	_____	_____
3. Miscellaneous Property in Sec.	S	_____	_____	_____
	S	_____	_____	_____

4. Lot No. \_\_\_\_\_, Recorded Plat \_\_\_\_\_  
5. Private Claims \_\_\_\_\_

**RAYMOND J. McCOY** **May 17 99**  
I, \_\_\_\_\_, in a field survey on \_\_\_\_\_, 19\_\_\_\_ do hereby state that under requirements of P.A. 74, Michigan P.A. of 1970, the corner points mentioned in lines 1 and 2 above were in conformance with regulations and rules therefore as required in the current manual of survey instructions of the United States Department of the Interior, Bureau of Land Management or by a decree of a Court of Law and for that the corner points mentioned in lines 3, 4 and 5 above were in conformance with the rules of the Michigan Board of Land Surveyors or by a Decree of a Court of Law; established, re-established, monumented, recovered, found as expressed below:

NOTE: Not more than 2 corners, all in the same town and range, may be recorded on this certificate.

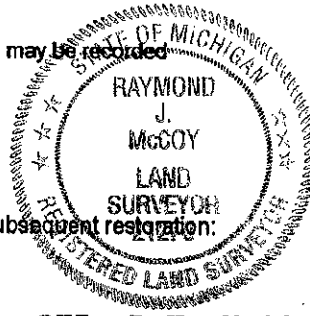

	A	B	C	D	E	F	G	H	I	J	K	L
1												
2		6		5		4		3		2		1
3												
4		7		8		9		10		11		12
5												
6		10		17		16		15		14		13
7												
8		19		20		21		22		23		24
9												
10		30		29		28		27		26		25
11												
12		31		32		33		34		35		36
13												

A. Description of original monument and accessories and/or subsequent restoration:  
**WAMPLER, D.S., SET POST**  
**THERE ARE 3 LCRC'S RECORDED.**  
1) 1980- Buckerfield, L. 7777, Pg. 375, P.K. Nail, 2 remaining witnesses.  
2) 1986- Erickson, L. 9905, Pg. 508, P.K. Nail, 4 remaining witnesses  
3) 1991- Moran, L. 11762, Pg. 149, P.K. Nail

B. Description of corner evidence found and/or method applied in restoring or reestablishing corner:  
Found capped iron #25860(MDOT) in Monument Box, 2ft. South of centerline of Auburn Road. The corner was recovered by using the remaining witnesses from the LCRC's above. Also from witnesses from a survey by Roskelly(L.15333, Pg. 596, 1995). Corner was validated by the measured distance Westerly to J-11 (3093.44 Meas. Ground Distance, 3093.72 S/P #11).

State Plane Coordinates N 415136.1291  
E 13429690.1062

C. Description of monument for corner and accessories established to perpetuate locating the position of the corner:  
Set a 5/8"x24" iron rod with 2" diameter brass disk stamped Oakland County Remonumentation P.S. #21270 in the existing monument box.  
Witnesses:  
S 63° W, 61.96', Set OCRT #21270 in NW face of Power Pole  
S 35° E, 59.79', Set OCRT #21270 in West face of Twin 14" Box Elder  
N 10° W, 24.40', Set OCRT #21270 in East face of Power Pole  
N 50° W, 79.67', Set OCRT #21270 in South face of 30" Maple  
THE SELECTED LOCATION IS ACCEPTED BY ME AND IS GENERALLY ACCEPTED BY PROFESSIONAL SURVEYORS AS THE BEST AVAILABLE EVIDENCE OF THE POSITION OF THE ORIGINAL CORNER.

Signed by Raymond J. McCoy  
Surveyor's Michigan License No. 21270

Date May 28, 1999