

LAND CORNER RECORDATION CERTIFICATE

Filing Requirement of Act 74, Mich. P.A. 1970 31128

For corners in

Oakland

(County)

Located in:

Pontiac

Twp. Corner Code #

LIBER 21052 PAGE 180
 \$7.00 MISC RECORDING
 \$2.00 REMONUMENTATION
 02/01/2000 09:59:20 A.M. RECEIPT# 7944
 PAID RECORDED - OAKLAND COUNTY
 B. WILLIAM CADDELL, CLERK/REGISTER OF DEEDS

- | | | | |
|------------------------------------|------|-----------------|-------------|
| 1. Public Land Survey | | <u>T3N R10E</u> | <u>K-12</u> |
| | | T___ R___ | _____ |
| | | T___ R___ | _____ |
| | | T___ R___ | _____ |
| 2. Property Controlling in Section | S___ | T___ R___ | _____ |
| | S___ | T___ R___ | _____ |
| 3. Miscellaneous Property in Sec. | S___ | T___ R___ | _____ |
| | S___ | T___ R___ | _____ |

7-7-99 516
 OAKLAND COUNTY REGISTER OF DEEDS
 WILLIAM CADDELL, CLERK/REGISTER OF DEEDS

Register of Deeds Stamp & File Number

4. Lot No. _____, Recorded Plat _____
 5. Private Claims _____

Raymond J. McCoy June 3 99

I, _____, in a field survey on _____, 19____ do hereby state that under requirements of P.A. 74, Michigan P.A. of 1970, the corner points mentioned in lines 1 and 2 above were in conformance with regulations and rules therefore as required in the current manual of survey instructions of the United States Department of the Interior, Bureau of Land Management or by a decree of a Court of Law and /or that the corner points mentioned in lines 3, 4 and 5 above were in conformance with the rules of the Michigan Board of Land Surveyors or by a Decree of a Court of Law; established, re-established, monumented, recovered, found as expressed below:

NOTE: Not more than 2 corners, all in the same town and range, may be recorded on this certificate.


	A	B	C	D	E	F	G	H	I	J	K	L	M
1													
2	6		5		4		3		2		1		
3													
4	7		8		9		10		11		12		
5													
6	18		17		16		15		14		13		
7													
8	19		20		21		22		23		24		
9													
10	30		29		28		27		26		25		
11													
12	31		32		33		34		35		36		
13													

A. Description of original monument and accessories and/or subsequent restoration:

1817 Post GLO

There is one LCRC recorded.

1) 1978-Buckerfield, L. 7283, Pg. 208, Fd. 1/2" bar, 1 witness

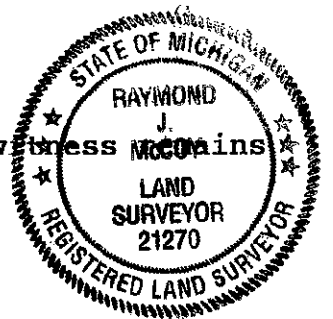

B. Description of corner evidence found and/or method applied in restoring or reestablishing corner:

Found a 5/8"x12" iron 12" deep. This area has been recently disturbed. Corner was recovered from monumentation found in "OAK GROVE SUBDIVISION" (L. 33, Pg. 39, 1924) with measured distances and angles fitting very closely to the recorded, between the found monumentation. Corner was validated by fitting the remaining witness in the above LCRC and matching closely with the recorded 1/2 mile distance to both K-11 & K-13.

State Plane Coordinates N 412463.4567
 E 13429821.7655

C. Description of monument for corner and accessories established to perpetuate locating the position of the corner:

Set a concrete monument consisting of a 1/2" iron rod encased in a 4" diameter brass-concrete cylinder 36" long with a 2" diameter brass disk stamped Oakland County Remonumentation P.S. #21270.

Witnesses:

- N 03° W, 113.83 Set OCRT in E. face of Power Pole
- N 81° W, Set OCRT in S. face of Power Pole
- N 53° E, 16.94 feet to SW corner of foundation of HSE #32 Caroline St.
- N 86° W, 50.03 Set Punch Hole in Top of Chain Linked Fence Post.

THE SELECTED LOCATION IS ACCEPTED BY ME AND IS GENERALLY ACCEPTED BY PROFESSIONAL SURVEYS AS THE BEST AVAILABLE EVIDENCE OF THE POSITION OF THE ORIGINAL CORNER.

Signed by Raymond J. McCoy
 Surveyor's Michigan License No. 21270

Date 1-5-00