

LAND CORNER RECORDATION CERTIFICATE  
Filing Requirement of Act 74, Mich. P.A. 1970

For corners in

PONTIAC

OAKLAND

(County)

Located In: TWP. Corner Code # L-11

206149

LIBER 20101 PAGE 709  
\$7.00 MISC RECORDING  
\$2.00 REMONUMENTATION  
06/10/1999 12:32:43 P.M. RECEIPT# 41597  
PAID RECORDED - OAKLAND COUNTY  
G. WILLIAM CABELL, CLERK/REGISTER OF DEEDS

Compliance with  
ACT 345, P.A. 1990

APPROVED ON: 5-26-99 JS  
OAKLAND COUNTY REMONUMENTATION  
PEER GROUP COMMITTEE

Register of Deeds Stamp & File Number

- |                                    |                          |             |
|------------------------------------|--------------------------|-------------|
| 1. Public Land Survey              | T <u>3N</u> R <u>10E</u> | <u>L-11</u> |
|                                    | T ___ R ___              | _____       |
|                                    | T ___ R ___              | _____       |
|                                    | T ___ R ___              | _____       |
| 2. Property Controlling in Section | S ___ T ___ R ___        | _____       |
|                                    | S ___ T ___ R ___        | _____       |
| 3. Miscellaneous Property in Sec.  | S ___ T ___ R ___        | _____       |
|                                    | S ___ T ___ R ___        | _____       |

4. Lot No. \_\_\_\_\_, Recorded Plat \_\_\_\_\_  
5. Private Claims \_\_\_\_\_

RAYMOND J. McCOY

May 19 99

I, \_\_\_\_\_, in a field survey on \_\_\_\_\_, 19\_\_\_\_ do hereby state that under requirements of P.A. 74, Michigan P.A. of 1970, the corner points mentioned in lines 1 and 2 above were in conformance with regulations and rules therefore as required in the current manual of survey instructions of the United States Department of the Interior, Bureau of Land Management or by a decree of a Court of Law and /or that the corner points mentioned in lines 3, 4 and 5 above were in conformance with the rules of the Michigan Board of Land Surveyors or by a Decree of a Court of Law; established, re-established, monumented, recovered, found as expressed below:


NOTE: Not more than 2 corners, all in the same town and range, may be recorded on this certificate.

	A	B	C	D	E	F	G	H	I	J	K	L	M
1													
2	6		5		4		3		2		1		
3													
4	7		8		9		10		11		12		
5													
6	18		17		16		15		14		13		
7													
8	19		20		21		22		23		24		
9													
10	30		29		28		27		26		25		
11													
12	31		32		33		34		35		36		
13													

A. Description of original monument and accessories and/or subsequent restoration:

WAMPLER, D.S., SET POST  
THERE IS ONE LCRC RECORDED.

1) 1991, Moran, L. 11762, Pg. 149, Found 3/4" iron pipe with 3/8" rod inside, 3 remaining witnesses.

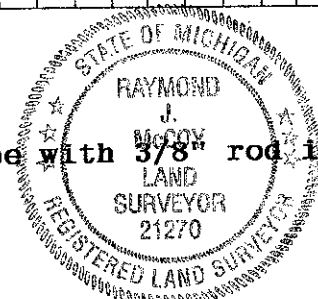

B. Description of corner evidence found and/or method applied in restoring or reestablishing corner:

Found 1/2" rod in Monument Box, centerline of Auburn Rd., 14ft East of centerline of Juniper St. Recovered corner from remaining witnesses of the above LCRC. Validated corner by using the found monumentation in "CHERRYLAND SUBDIVISION"(L.48, Pg. 3, 1927).

State Plane Coordinates N 415281.0200  
E 13432353.7681

C. Description of monument for corner and accessories established to perpetuate locating the position of the corner:

Replaced the found 1/2" rod with a 5/8"x24" iron rod with a 2" diameter brass disk stamped Oakland County Remonumentation P.S. #21270 in the existing monument box.

Witnesses:

- N 19° W, 80.95, Set OCRT #21270 in NE face of 12" locust
- N 23° E, 34.82, Set OCRT #21270 in NW face of Power Pole
- S 20° E, 37.15, Set OCRT #21270 in West face of Power Pole
- S 30° W, 62.65, Set OCRT #21270 in West face of Power Pole.

THE SELECTED LOCATION IS ACCEPTED BY ME AND IS GENERALLY ACCEPTED BY PROFESSIONAL SURVEYORS AS THE BEST AVAILABLE EVIDENCE OF THE POSITION OF THE ORIGINAL CORNER.

Signed by \_\_\_\_\_ Date May 28, 1999

Surveyor's Michigan License No. 21270