

SEE REVERSE SIDE FOR SKETCH

LAND CORNER RECORDATION CERTIFICATE
Filing Requirement of Act 74, Mich. P.A. 1970

206180

For corners in

Oakland

(County)

Located In: Pontiac Twp. Corner Code # M-5

LIBER 20101 PAGE 734
\$9.00 MISE RECORDING
\$2.00 REMONUMENTATION
06/10/1999 12:32:47 P.M. RECEIPT# 41597
PAID RECORDED - OAKLAND COUNTY
G. WILLIAM CADDELL, CLERK/REGISTER OF DEEDS

Compliance with
ACT 345, P.A. 1990

APPROVED ON: 3-18-99 JS
OAKLAND COUNTY REMONUMENTATION
PEER GROUP COMMITTEE

Register of Deeds Stamp & File Number

1. Public Land Survey	T	<u>3NR 10E</u>	<u>M-5</u>
	T	_____	_____
	T	_____	_____
	T	_____	_____
2. Property Controlling in Section	S	T	_____
	S	T	_____
3. Miscellaneous Property in Sec.	S	T	_____
	S	T	_____

4. Lot No. _____, Recorded Plat _____
5. Private Claims _____

Raymond J. McCoy Mar. 8 99


I, _____, in a field survey on _____, 19____ do hereby state that under requirements of P.A. 74, Michigan P.A. of 1970, the corner points mentioned in lines 1 and 2 above were in conformance with regulations and rules therefore as required in the current manual of survey instructions of the United States Department of the Interior, Bureau of Land Management or by a decree of a Court of Law and /or that the corner points mentioned in lines 3, 4 and 5 above were in conformance with the rules of the Michigan Board of Land Surveyors or by a Decree of a Court of Law; established, re-established, monumented, recovered, found as expressed below:

NOTE: Not more than 2 corners, all in the same town and range, may be recorded on this certificate.

A	B	C	D	E	F	G	H	I	J	K	L
1											
2	6		5		4		3		2		1
3											
4	7		8		9		10		11		12
5											
6	18		17		16		15		14		13
7											
8	19		20		21		22		23		24
9											
10	30		29		28		27		26		25
11											
12	31		32		33		34		35		36
13											

A. Description of original monument and accessories and/or subsequent restoration:

Wampler, D.S. Set Post
There are NO L.C.R.C.'s recorded.

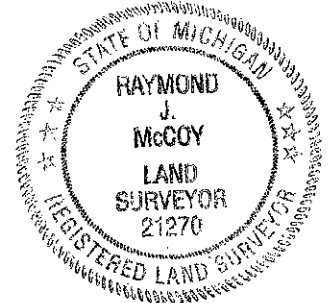

B. Description of corner evidence found and/or method applied in restoring or reestablishing corner:

No corner was found. The corner was established from Buckerfield Survey (1968) & 1994) using the recorded angle at the South 1/4 corner (L-5) formed by the Center of Section (L-4) and the South line of Section 12 (As shown in said Surveys), being 91°24'49", extending east to intersect the East line of Section 12. The East line of Section 12 was established by extending a line from the East 1/4 corner (M-4) through the S.W. corner of Section 7 (T3N, R11E). The S.W. corner of "HUNTERS CREEK SUBDIVISION" (L. 156, Pgs 1-4, 1978) falls on the East Section line. The M-5 corner falls on the southerly extension of a Tree & Power Line that runs North, North of Walton Blvd.

State Plane Coordinates N 431846.976
E13433812.446

C. Description of monument for corner and accessories established to perpetuate locating the position of the corner:

Set a concrete monument, consisting of a 1/2" iron rod encased in a 4" diameter concrete cylinder 36" long with a 2" diameter brass disk stamped Oakland County Remonumentation P.S. #21270.

Witnesses:

- Northerly, along east section line, 50.00' to a capped iron rod (#21270)
- Westerly, along South section line, 50.00' to a capped iron rod (#21270)
- South, 50.00' to a capped iron rod (#21270)
- East, 50.00' to a capped iron rod (#21270)
- Northerly, 410.43' to A-5 (T3N, R11E)

THE SELECTED LOCATION IS ACCEPTED BY ME AND IS GENERALLY ACCEPTED BY PROFESSIONAL SURVEYORS AS THE BEST EVIDENCE OF THE POSITION OF THE ORIGINAL CORNER.

Signed by Raymond J. McCoy
Surveyor's Michigan License No. 21270

Date 6-4-99

(SEE BACK FOR SKETCH)