

LAND CORNER RECORDATION CERTIFICATE 31131

Filing Requirement of Act 74, Mich. P.A. 1970 PAGE 183

For corners in
Oakland
(County)

Pontiac

Located in: Twp. Corner Code #

\$7.00 MISC RECORDING
\$2.00 REMONUMENTATION
02/01/2000 09:59:20 A.M. RECEIPT# 7944
PAID RECORDED - OAKLAND COUNTY
G. WILLIAM CADDELL, CLERK/REGISTER OF DEEDS

1. Public Land Survey

T 3N R 10E M-6
T ___ R ___
T ___ R ___
T ___ R ___
T ___ R ___

2. Property Controlling
in Section

S ___ T ___ R ___
S ___ T ___ R ___
S ___ T ___ R ___

3. Miscellaneous
Property in Sec.

S ___ T ___ R ___
S ___ T ___ R ___
SECTION

Compliance with
ACT 345, P.A. 1993
APPROVED ON: 10-13-99 JI
OAKLAND COUNTY REMONUMENTATION
PEER GROUP COMMITTEE
Register of Deeds Stamp & File Nu

4. Lot No. _____, Recorded Plat _____
5. Private Claims _____

Raymond J. McCoy Sept. 23 99


I, _____, in a field survey on _____, 19____ do hereby state that under requirements of P.A. 74, Michigan P.A. of 1970, the corner points mentioned in lines 1 and 2 above were in conformance with regulations and rules therefore as required in the current manual of survey instructions of the United States Department of the Interior, Bureau of Land Management or by a decree of a Court of Law and/or that the corner points mentioned in lines 3, 4 and 5 above were in conformance with the rules of the Michigan Board of Land Surveyors or by a Decree of a Court of Law; established, re-established, monumented, recovered, found as expressed below.

	A	B	C	D	E	F	G	H	I	J	K
1											
2	6			5			4			3	2
3											
4	7			8			9			10	11
5											
6	10			17			16			15	14
7											
8	19			20			21			22	23
9											
10	30			29			28			27	26
11											
12	31			32			33			34	35
13											

NOTE: Not more than 2 corners, all in the same town and range, may be recorded on this certificate.

A. Description of original monument and accessories and/or subsequent restoration:

1817 Post GLO
There is no LCRC's recorded for this corner.

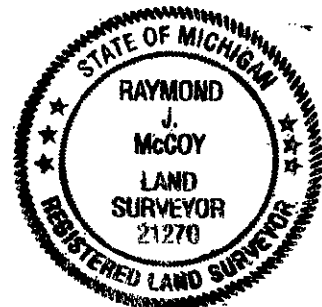

B. Description of corner evidence found and/or method applied in restoring or reestablishing corner:

No corner was found. Corner was established midway between and on line between M-5 & M-7.

State Plane Coordinates N 429246.8100
E 13433942.9342

lp
R

C. Description of monument for corner and accessories established to perpetuate locating the position of the corner:

Set a 5/8"x24" iron rod with a 2" diameter brass disk stamped Oakland County Remonumentation P.S. #21270 in a New Monument Box in a parking Lot of Oakland University.

Witnesses:

N 5° E, 117.63, Set chiseled "x" on SE corner of Metal Lightpole Base
S 64° E, 118.50, Set chiseled "x" on SW cor. Metal Lightpole Base
S 19° W, 151.04', Set chiseled "x" NW cor. metal lightpole Base
S 80° W, 32.88 Top of NE screw NE cor. of Metal Lightpole Base

THE SELECTED LOCATION IS ACCEPTED BY ME AND IS GENERALLY ACCEPTED BY PROFESSIONAL SURVEYORS AS THE BEST AVAILABLE EVIDENCE OF THE POSITION OF THE ORIGINAL CORNER.

Signed by Raymond J. McCoy
Surveyor's Michigan License No. 21270

Date 10-5-00