

LAND CORNER RECORDATION CERTIFICATE
Filing Requirement of Act 74, Mich. P.A. 1970

31133

For corners in

Oakland

(County)

Located in: Pontiac
Twp - Corner Code #

LIBER 21052 PAGE 185
\$7.00 MISC RECORDING
\$2.00 REMONUMENTATION
02/01/2000 09:59:20 A.M. RECEIPT# 7944
PAID RECORDED - OAKLAND COUNTY
G. WILLIAM CADDELL, CLERK/REGISTER OF DEEDS

1. Public Land Survey	T <u>3N</u> R <u>10E</u>	<u>M-8</u>
	T___ R___	_____
	T___ R___	_____
	T___ R___	_____
2. Property Controlling in Section	S___ T___ R___	_____
	S___ T___ R___	_____
3. Miscellaneous Property in Sec.	S___ T___ R___	_____
	S___ T___ R___	_____

Register of Deeds Stamp & File Number

4. Lot No. _____, Recorded Plat _____
5. Private Claims _____

Sept. 23 99


I, Raymond J. McCoy, a field surveyor on _____, 19____ do hereby state that under requirements of P.A. 74, Michigan P.A. of 1970, the corner points mentioned in lines 1 and 2 above were in conformance with regulations and rules therefore as required in the current manual of survey instructions of the United States Department of the Interior, Bureau of Land Management or by a decree of a Court of Law and /or that the corner points mentioned in lines 3, 4 and 5 above were in conformance with the rules of the Michigan Board of Land Surveyors or by a Decree of a Court of Law; established, re-established, monumented, recovered, found as expressed below:

NOTE: Not more than 2 corners, all in the same town and range, may be recorded on this certificate.

	A	B	C	D	E	F	G	H	I	J	K	L	M
1													
2	6		5		4		3		2		1		
3													
4	7		8		9		10		11		12		
5													
6	18		17		16		15		14		13		
7													
8	19		20		21		22		23		24		
9													
10	30		29		28		27		26		25		
11													
12	31		32		33		34		35		36		
13													

A. Description of original monument and accessories and/or subsequent restoration:

1817 Post GLO
There are 2 LCRC's recorded for this corner.
1) 1991-Kohn, L. 11750, Pg.897, Found 1/2" rod.
2) 1991-DeDecker, L. 12014, Pg. 750, Found 1/2" rod, 2 remaining

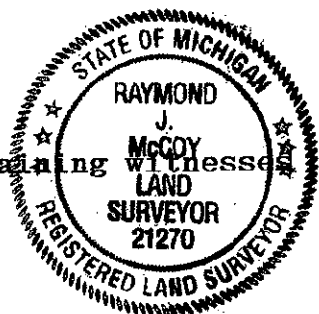

B. Description of corner evidence found and/or method applied in restoring or reestablishing corner:
Found 1/2" iron @ the intersection of Tree Row running North-South, East-West. Recovered corner from the remaining witnesses in the above LCRC's and from a Survey by Giffels-Webster Engineers(9/85, 3 remaining witnesses)

State Plane Coordinates N 423945.3834
E 13434212.4316

C. Description of monument for corner and accessories established to perpetuate locating the position of the corner:
Set a concrete monument consisting of a 1/2" iron rod encased in a 4" diameter concrete cylinder 36" long with a 2" diameter brass disk stamped Oakland County Remonumentation P.S. #21270.

Witnesses:
North, 225.75' Set OCRT in W. face of 28" Oak
S 65° E, 14.63' Set OCRT in NE face 16" Ash
S 45° W, 9.19' Set OCRT in SE face of 7" Cherry
N 45° W, 16.07' Set OCRT SW face of 20" Poplar

THE SELECTED LOCATION IS ACCEPTED BY ME AND IS GENERALLY ACCEPTED BY PROFESSIONAL SURVEYORS AS THE BEST AVAILABLE EVIDENCE OF THE POSITION OF THE ORIGINAL CORNER.

Signed by Raymond J. McCoy
Surveyor's Michigan License No. 21270

Date 1-25-00