

LIBER 21052 186

LAND CORNER RECORDATION CERTIFICATE  
Filing Requirement of Act 74, Mich. P.A. 1970

For corners in  
Oakland  
(County)

Located In: Pontiac Twp. Corner Code #

31134

1. Public Land Survey

T3N R10E SECTION M-9  
T\_\_\_ R\_\_\_  
T\_\_\_ R\_\_\_

2. Property Controlling  
in Section

S\_\_\_ T\_\_\_ R\_\_\_ MAR 21 2000

3. Miscellaneous  
Property in Sec.

S\_\_\_ T\_\_\_ R\_\_\_ SECTION

LIBER 21052 PAGE 186  
\$7.00 MISC RECORDING  
\$2.00 REMONUMENTATION  
02/01/2000 09:59:20 A.M. RECEIPT# 7944  
PAID RECORDED - OAKLAND COUNTY  
G. WILLIAM CADDELL, CLERK/REGISTER OF DEEDS  
MICHIGAN P.A. 1999  
9-15-99 JR  
Register of Deeds Stamp & File Num


4. Lot No. \_\_\_\_\_, Recorded Plat \_\_\_\_\_  
5. Private Claims \_\_\_\_\_

Raymond J. McCoy September 3 99

I, \_\_\_\_\_, in a field survey on \_\_\_\_\_, 19\_\_\_\_ do hereby state that under requirements of P.A. 74, Michigan P.A. of 1970, the corner points mentioned in lines 1 and 2 above were in conformance with regulations and rules therefore as required in the current manual of survey instructions of the United States Department of the Interior, Bureau of Land Management or by a decree of a Court of Law and /or that the corner points mentioned in lines 3, 4 and 5 above were in conformance with the rules of the Michigan Board of Land Surveyors or by a Decree of a Court of Law; established, re-established, monumented, recovered, found as expressed below:

NOTE: Not more than 2 corners, all in the same town and range, may be recorded on this certificate.

	A	B	C	D	E	F	G	H	I	J	K
1											
2	6			5			4			3	2
3											
4	7			8			9			10	11
5											
6	18			17			16			15	14
7											
8											
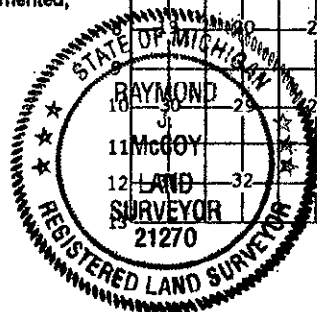

A. Description of original monument and accessories and/or subsequent restoration:

1817 Post GLO  
There are 3 LCRC's recorded for this corner.  
1) 1918-Nicolaescu, L. 7960, Pg. 580, Fd. 3/8" rebar, All witnesses gone  
2) 1987-Wilerson, L. 10244, Pg.7, Fd. 3/8" rod, 2 witnesses remain  
3) 1991-Kohn, L. 11170, Pg. 897, 2 witnesses recovered.

B. Description of corner evidence found and/or method applied in restoring or reestablishing corner:

Found capped iron(#26459), 500'+/-SSE from the EDS Building and North of the Clinton River and 35.66 feet North of a 1/2" rod(A-9, Avon Twp.). Recovered corner from the remaining witnesses in the above LCRC's and from various Surveys. Validated corner by measuring closely with the 1965 MSHD Survey South & West.

State Plane Coordinates N 421301.0200  
E 13434344.1154

C. Description of monument for corner and accessories established to perpetuate locating the position of the corner:  
Set a concrete monument consisting of a 1/2" iron rod encased in a 4" diameter concrete cylinder 36" long with a 2" diameter brass disk stamped Oakland County Remonumentation P.S. #21270.

Witnesses:  
N 12° E, 31.47' Set OCRT in W. face of 16" Box Elder  
N 40° W, Set OCRT in W. face of 16" Box Elder  
N 75° W, 64.00 Set OCRT in NE face of 12" Ash  
S 60° E, 31.64' Set OCRT in NE face of 6" Ash

THE SELECTED LOCATION IS ACCEPTED BY ME AND IS GENERALLY ACCEPTED BY PROFESSIONAL SURVEYS AS THE BEST AVAILABLE EVIDENCE OF THE POSITION OF THE ORIGINAL CORNER.

Signed by Raymond J. McCoy  
Surveyor's Michigan License No. 21270

Date 1-5-00