

Oakland Co.

LAND CORNER RECORDATION CERTIFICATE

FILING REQUIREMENT OF ACT 74, MICH. P.A.1970

FOR CORNERS OF--	LOCATED IN--	CORNER CODE NUMBER
1. PUBLIC LAND SURVEY <u>13</u>	T. <u>3</u> ^{N.} S. R. <u>11</u> ^{E.} W.	<u>L-7</u>
2. PROPERTY CONTROLLING IN SECTION <u>13</u>	T. <u>3</u> ^{N.} S. R. <u>11</u> ^{E.} W.	<u>9, 16</u>
3. MISCELLANEOUS PROPERTY IN SECTION _____	T. _____ ^{N.} S. R. _____ ^{E.} W.	_____
4. LOT NO. _____	RECORDED PLAT _____	_____
5. PRIVATE CLAIMS _____	_____	_____

REGISTER OF DEEDS STAMP AND FILING NUMBER

I, Donald L. Bissell, do hereby certify that under requirements of P.A. 74, Michigan P.A. of 1970, the corner points mentioned in lines 1 and 2 above were, in a field survey on August, 19 86, established, re-established, monumented, re-monumented, recovered or restored as expressed below and in conformance with regulations and rules therefore as required in the current manual of survey instructions of the United States Department of the Interior, Bureau of Land Management or by a decree of a court of law. Furthermore, that the corner points mentioned in lines 3, 4 and 5 above were, in a field survey on _____, 19____, found, recovered, restored, established or re-established as expressed below and in conformance with the rules of the Michigan State Board of Registration for Land Surveyors or, by a Decree of a Court of law:

A. Description of original monument and accessories and/or subsequent restoration:

B. Description of corner evidence found and/or method applied in restoring or re-establishing corner:

- L-7 Found concrete monument at end of 8' fence West and 4' fence East
 - 24" Locust - W.S.W. - 12.40'
 - 18" Locust - E.S.E. - 48.14'
 - 12" Oak - S.S.E. - 9.33'

C. Description of monument for corner and accessories established to perpetuate locating the position of the corner:

- | | |
|---|---|
| <ul style="list-style-type: none"> L-7 S 1/4 Corner <ul style="list-style-type: none"> Concrete monument 24" Locust - W.S.W. - 12.40' 18" Locust - E.S.E. - 48.14' 12" Oak - S.S.E. - 9.33' | <ul style="list-style-type: none"> 9. N 1/8 Corner of SE 1/4 <ul style="list-style-type: none"> Set 4" x 36" concrete monument with aluminum cap S 1°W - 55.89' - power pole N 85°W - 33.92' - 10" Maple N 26°W - 48.60' - 4" Elm N 56°E - 25.56' - 5" Hickory |
| <ul style="list-style-type: none"> 16. S 1/8 corner of SE 1/4 Found concrete monument <ul style="list-style-type: none"> N 82°W - 56.3' - fence corner N 63°W - 56.34' - 12" B. Oak | <ul style="list-style-type: none"> N 24°W - 80.39' - 20" B. Oak N 65°W - 30.20' - R.R. Tie on end |

SIGNED BY _____ DATE _____


SURVEYOR'S MICHIGAN REGISTRATION NO. _____

FOR STATE AND UNITED STATES AGENCIES:

SIGNED BY _____ DATE _____

APPROVED AND SIGNED BY Donald L. Bissell
MICHIGAN REGISTERED LAND SURVEYOR

DATE 12-3-86

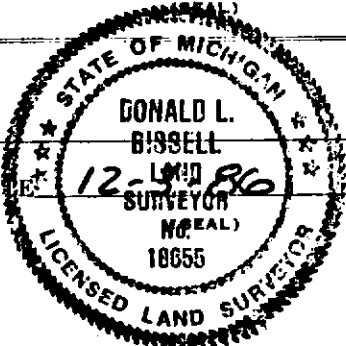

SURVEYOR'S MICHIGAN REGISTRATION NO. 18655