

LAND CORNER RECORDATION CERTIFICATE

FILING REQUIREMENT OF ACT 74, MICH. P.A.1970

FOR CORNERS OF--:	LOCATED IN--:	CORNER CODE NUMBER
1. PUBLIC LAND SURVEY <u>13</u> T. <u>3</u> N. <u>8.</u> R. <u>11</u> E.		<u>L-6, K-6</u>
2. PROPERTY CONTROLLING IN SECTION _____, T. _____, S., R. _____ E.		
3. MISCELLANEOUS PROPERTY IN SECTION _____, T. _____, S., R. _____ E.		
4. LOT NO. _____, RECORDED PLAT _____		
5. PRIVATE CLAIMS _____		

REGISTER OF DEEDS STAMP AND FILING NUMBER

I, Donald L. Bissell, do hereby certify that under requirements of P.A. 74, Michigan P.A. of 1970, the corner points mentioned in lines 1 and 2 above were, in a field survey on August, 1986, established, re-established, monumented, re-monumented, recovered or restored as expressed below and in conformance with regulations and rules therefore as required in the current manual of survey instructions of the United States Department of the Interior, Bureau of Land Management or by a decree of a court of law. Furthermore, that the corner points mentioned in lines 3, 4 and 5 above were, in a field survey on _____, 19____, found, recovered, restored, established or re-established as expressed below and in conformance with the rules of the Michigan State Board of Registration for Land Surveyors or, by a Decree of a Court of law:

A. Description of original monument and accessories and/or subsequent restoration:

L-6 None	K-6 Nail in pavement NW-43.06' - 24" tree NE-41.36' - 24" tree SE-41.48' - pole
----------	--

B. Description of corner evidence found and/or method applied in restoring or re-establishing corner:

L-6 Set with measurements E-W and S by Postiff Company 1970	K-6 Set from witnesses by Giffels-Webster. Dug hole in pavement and found nothing but pavement re-rod. Accepted nail because of amount of property tied to it fits distance of Indian Trail on G.L.O. Survey.
---	--

C. Description of monument for corner and accessories established to perpetuate locating the position of the corner:

L-6 Center Section Set 4" x 36" concrete monument with aluminum cap. N 25°W - 26.40' - 8" Twin Ash N 69°E - 42.99' - 6" Ash S 13°E - 67.09' - 12" Walnut S 49°W - 73.71' - P.P. @ bend in line	K-6 W 1/4 Corner Set 3/4" iron and monument box S 51°E - 41.48' - power pole N 39°W - 43.06' - 18" Hickory N 64°E - 41.36' - 20" Maple S 70°W - 70.85' - 6" Twin Maple
---	---


SIGNED BY _____ DATE _____

SURVEYOR'S MICHIGAN REGISTRATION NO. _____

FOR STATE AND UNITED STATES AGENCIES:

SIGNED BY _____ DATE _____

APPROVED AND SIGNED BY Donald L. Bissell DATE _____
CHIEF OF SURVEY PARTY
MICHIGAN REGISTERED LAND SURVEYOR

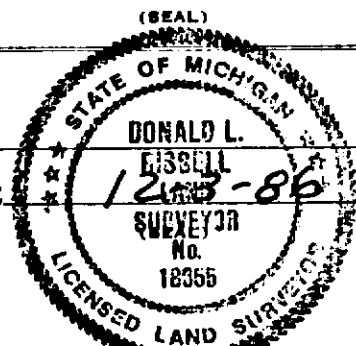

SURVEYOR'S MICHIGAN REGISTRATION NO. 18655