

SURVEY & REMONUMENTATION

MAY 24 2000

LIBER 21119 641

SECTION

LAND CORNER RECORDATION CERTIFICATE 51707
Filing Requirement of Act 74, Mich. P.A. 1970

LIBER 21119 PAGE 641
 \$9.00 MISC RECORDING
 \$2.00 REMONUMENTATION
 02/18/2000 02:36:27 P.M. RECEIPT# 14203
 PAID RECORDED - OAKLAND COUNTY
 G. WILLIAM CADDELL, CLERK/REGISTER OF DEEDS

For corners in

<u>Oakland</u> (county)	Located in:	Corner Code #
	Rose Township	
1. Public Land Survey	T4N R7E	A-7
	T R	
	T R	
	T R	
2. Property Controlling in Section	S T R	
	S T R	
3. Miscellaneous Property in Sec.	S T R	
	S T R	

10-13-99 JA
 OAKLAND COUNTY REGISTER OF DEEDS
 REGISTER OF DEEDS STAMP & FILE NUMBER

4. Lot No. _____, Recorded Plat _____
 5. Private Claims _____

I, Joseph C. Kapelczak, in a field survey on October 7, 1998, do hereby certify that under requirements of P.A. 74, Michigan P.A. of 1970, the corner points mentioned in lines 1 and 2 above were in conformance with regulations and rules therefore as required in the current manual of survey instructions of the United States Department of the Interior, Bureau of Land Management or by a decree of a Court of Law and/or that the corner points mentioned in lines 3, 4 and 5 above were in conformance with the rules of the Michigan Board of Land Surveyors or by a Decree of a Court of Law; established, re-established, monumented, re-monumented, recovered, found as expressed below:

	A	B	C	D	E	F	G	H	I	J	K	L
2	6	5	4	3	2	1						
3												
4	7	8	9	10	11	12						
5												
6	13	14	15	16	17	18						
7												
8	19	20	21	22	23	24						
9												
10	25	26	27	28	29	30						
11												
12	31	32	33	34	35	36						
13												

A. Description of original monument and accessories and/or subsequent restoration:

Set post in 1816 G.L.O. Survey.
 There is one LCRC recorded at Oakland County; Ward 1987.

B. Description of corner evidence found and/or method applied in restoring or reestablishing corner:

Recovered a 1/2" iron in Tipsico Lake Road 0.14' west of Tyrone Township line and 117.32' south of M-7, Tyrone Township. Validated location with monumentation recovered along east line of T.4N., R.6E., Tyrone Township, Livingston County and along R.O.W. of Tipsico Lake Road.


C. Description of monument for corner and accessories established to perpetuate locating the position of the corner:

Set 5/8" iron with Oakland County Remonumentation Brass Cap stamped #24598.

Set Witnesses:

- N 25°W 31.14' nail with OCRT #24598 west side 12" Locust.
- N 29°E 38.14' nail with OCRT #24598 west side 10" Locust.
- N 68°E 23.59' nail with OCRT #24598 north side 12" Locust.
- S 24°E 62.55' nail with OCRT #24598 west side 8" Locust.

JP
R

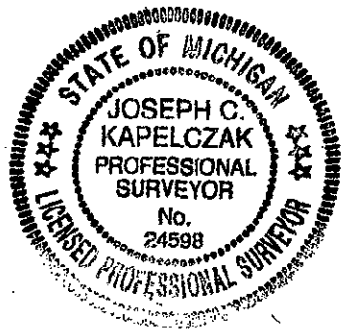

Signed by Joseph C. Kapelczak
 Surveyor's Michigan License No. 24598

Date 10/12/99