

MAY 24 2000

LAND CORNER RECORDATION CERTIFICATE
Filing Requirement of Act 74, Mich. P.A. 1970

374930

SECTION

For corners in

<u>Oakland</u> (county)	Located in:	Corner Code #
	Rose Township	
1. Public Land Survey	T4N R7E	B-9
	T R	
	T R	
	T R	
2. Property Controlling in Section	S T R	
	S T R	
3. Miscellaneous Property in Sec.	S T R	
	S T R	

LIBER 20657 PAGE 296
 \$9.00 MISC RECORDING
 \$2.00 REMONUMENTATION
 10/12/1999 08:06:33 A.M. RECEIPT# 88906
 PAID RECORDED - OAKLAND COUNTY
 G. WILLIAM CADDELL, CLERK/REGISTER OF DEEDS

Compliance with
 ACT 345, P.A. 1990
 6-16-99 JS
 APPROVED ON:
 OAKLAND COUNTY REMONUMENTATION
 PEER GROUP COMMITTEE
 Register of Deeds Stamp & File Number

4. Lot No. _____, Recorded Plat _____

5. Private Claims _____

I, Joseph C. Kapelczak, in a field survey on October 7, 1998, do hereby certify that under requirements of P.A. 74, Michigan P.A. of 1970, the corner points mentioned in lines 1 and 2 above were in conformance with regulations and rules therefore as required in the current manual of survey instructions of the United States Department of the Interior, Bureau of Land Management or by a decree of a Court of Law and/or that the corner points mentioned in lines 3, 4 and 5 above were in conformance with the rules of the Michigan Board of Land Surveyors or by a Decree of a Court of Law, established, re-established, monumented, re-monumented, recovered, found as expressed below.

A	B	C	D	E	F	G	H	I	J	K	L	M
2	6	5	4	3	2	1						
3												
4	7	8	9	10	11	12						
5												
6	16	17	18	19	14	13						
7												
8	19	20	21	22	23	24						
9												
10	30	29	28	27	26	25						
11												
12	31	32	33	34	35	36						
13												

NOTE: Not more than 4 corners, all in the same town and range, may be recorded on this certificate.

A. Description of original monument and accessories and/or subsequent restoration:

Set post in 1816 G.L.O. Survey.
 There are three LCRC's recorded at Oakland County; Anderson 1976, Ward 1987, and Bonno 1988.

B. Description of corner evidence found and/or method applied in restoring or reestablishing corner:

Recovered a concrete monument at this location. This location was validated with monumentation recovered from Ward Survey of Section 19.

*Recovered Witnesses:

- *N 10°E 10.98' nail with Grant Ward tag east side 24" Oak.
- *S 55°E 20.88' nail with Grant Ward tag southwest side 14" Box Elder.
- *S 85°E 21.81' nail with Grant Ward tag north 42" Oak.
- *S 25°W 10.53' nail with Grant Ward tag west side 8" Oak.


C. Description of monument for corner and accessories established to perpetuate locating the position of the corner:

Set Oakland County Remonumentation Brass Cap stamped #24598 on existing monument.

Set Witnesses:

- *N 10°E 10.98' OCRT #24598 and Mag nail east side 24" Oak.
- *S 55°E 20.88' OCRT #24598 and Mag nail southwest side 14" Box Elder.
- *S 85°E 21.81' OCRT #24598 and Mag nail north side 42" Oak.
- *S 25°W 10.53' OCRT #24598 and Mag nail west side 8" Cherry.

*Reused Recovered Witnesses

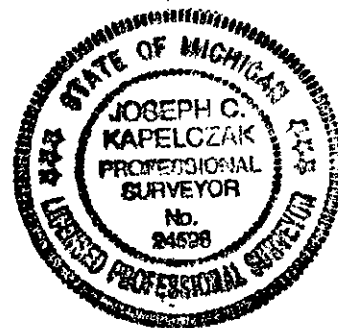

Signed by Joseph C. Kapelczak

Date 5/4/99

Surveyor's Michigan License No. 24598