

MAY 24 2000

LIBR 20657 306

SECTION

LAND CORNER RECORDATION CERTIFICATE  
Filing Requirement of Act 74, Mich. P.A. 1970

374935

For corners in

Oakland (county)	Located In: Rose Township	Corner Code #
1. Public Land Survey	T4N R7E	C-9
	T R	
	T R	
	T R	
2. Property Controlling in Section	S T R	
	S T R	
3. Miscellaneous Property in Sec.	S T R	
	S T R	

LIBER 20657 PAGE 306  
 \$9.00 MISC RECORDING  
 \$2.00 REMONUMENTATION  
 10/12/1999 08:06:33 A.M. RECEIPT# 88906  
 PAID RECORDED - OAKLAND COUNTY  
 G. WILLIAM CADDELL, CLERK/REGISTER OF DEEDS

Compliance with  
 ACT 345, P.A. 1990

APPROVED ON: 5-5-99 99-55  
 OAKLAND COUNTY REMONUMENTATION  
 PEER GROUP COMMITTEE  
 Register of Deeds Stamp & File Number

4. Lot No. \_\_\_\_\_ Recorded Plat \_\_\_\_\_

5. Private Claims \_\_\_\_\_

I, Joseph C. Kapelczak, in a field survey on April 10, 1998, do hereby certify that under requirements of P.A. 74, Michigan P.A. of 1970, the corner points mentioned in lines 1 and 2 above were in conformance with regulations and rules therefore as required in the current manual of survey instructions of the United States Department of the Interior, Bureau of Land Management or by a decree of a Court of Law and/or that the corner points mentioned in lines 3, 4 and 5 above were in conformance with the rules of the Michigan Board of Land Surveyors or by a Decree of a Court of Law, established, re-established, monumented, re-monumented, recovered, found as expressed below:

NOTE: Not more than 4 corners, all in the same town and range, may be recorded on this certificate.

A. Description of original monument and accessories and/or subsequent restoration:

Set post in 1816 G.L.O. Survey.

B. Description of corner evidence found and/or method applied in restoring or reestablishing corner:

There are seven LCRC's recorded at Oakland County; Pike 1973, Anderson 1974, Anderson 1976, Ward 1986, Bonno 1988, Bonno 1988, Ward 1995.

Recovered a 5/8" iron in monument box in Hickory Ridge Road at this location. This location was validated with monumentation recovered along the R.O.W. of Hickory Ridge Road north of section corner along with witnesses recovered in the recorded LCRC's.

\*Recovered Witnesses:

- \*West 34.14' PK nail with tag #17623 south side 12" Hickory.
- \*N 35°W 46.87' PK nail with 17623 northeast side 18" Hickory.
- \*N 35°W 46.87' nail with tag #32332 northeast side 18" Hickory.
- N 43°E 79.29' nail with tag #17623 northwest side power pole.
- \*N 43°E 79.29' nail with Grant Ward tag northwest side power pole.
- S 35°E 57.82' street sign post.
- \*S 29°E 134.21' nail with Grant Ward tag northeast side power pole.

2P  
R


C. Description of monument for corner and accessories established to perpetuate locating the position of the corner:

Set 5/8" iron with Oakland County Remonumentation Brass Cap stamped #24598 in existing monument box.

Set Witnesses:

- \*West 34.14' Mag nail with OCRT #24598 south side 12" Hickory.
- \*N 35°W 46.87' Mag nail with OCRT #24598 northeast side 18" Hickory.
- \*N 43°E 79.29' Mag nail with OCRT #24598 northwest side power pole.
- S 25°E 134.21' Mag nail with OCRT #24598 northeast side power pole.

\*Reused Recovered Witnesses

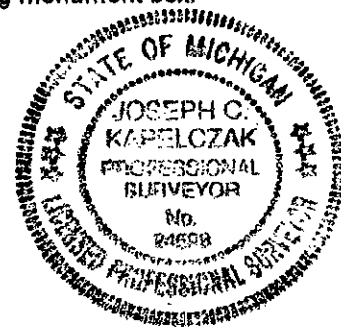

Signed by Joseph C. Kapelczak

Date 5/4/99

Surveyor's Michigan License No. 24598