

MAY 24 2000

LAND CORNER RECORDATION CERTIFICATE  
Filing Requirement of Act 74, Mich. P.A. 1970

51708

LIBER 21119 PAGE 643  
\$9.00 MISC RECORDING  
\$2.00 REMONUMENTATION  
02/18/2000 02:36:27 P.M. RECEIPT# 14203  
PAID RECORDED - OAKLAND COUNTY  
G. WILLIAM CADDELL, CLERK/REGISTER OF DEEDS

SECTION  
For corners in

|                                       |                         |               |
|---------------------------------------|-------------------------|---------------|
| <u>Oakland</u><br>(county)            | Located in:             | Corner Code # |
|                                       | Rose Township           |               |
| 1. Public Land Survey                 | T <u>4N</u> R <u>7E</u> | <u>C-12</u>   |
|                                       | T _____ R _____         | _____         |
|                                       | T _____ R _____         | _____         |
|                                       | T _____ R _____         | _____         |
| 2. Property Controlling<br>in Section | S _____ T _____ R _____ | _____         |
|                                       | S _____ T _____ R _____ | _____         |
| 3. Miscellaneous<br>Property in Sec.  | S _____ T _____ R _____ | _____         |
|                                       | S _____ T _____ R _____ | _____         |

Compliance with  
ACT 345, P.A. 1990  
APPROVED ON: 12-14-99 Jh  
OAKLAND COUNTY REMONUMENTATION  
PEER GROUP COMMITTEE

Register of Deeds Stamp & File Number

4. Lot No. \_\_\_\_\_, Recorded Plat \_\_\_\_\_

5. Private Claims \_\_\_\_\_

I, Joseph C. Kapelczak, in a field survey on April 9, 1998, do hereby certify that under requirements of P.A. 74, Michigan P.A. of 1970, the corner points mentioned in lines 1 and 2 above were in conformance with regulations and rules therefore as required in the current manual of survey instructions of the United States Department of the Interior, Bureau of Land Management or by a decree of a Court of Law and/or that the corner points mentioned in lines 3, 4 and 5 above were in conformance with the rules of the Michigan Board of Land Surveyors or by a Decree of a Court of Law; established, re-established, monumented, re-monumented, recovered, found as expressed below:

| A  | B  | C  | D  | E  | F  | G  | H | I | J | K | L | M |
|----|----|----|----|----|----|----|---|---|---|---|---|---|
| 2  | 6  | 5  | 4  | 3  | 2  | 1  |   |   |   |   |   |   |
| 3  |    |    |    |    |    |    |   |   |   |   |   |   |
| 4  | 7  | 8  | 9  | 10 | 11 | 12 |   |   |   |   |   |   |
| 5  |    |    |    |    |    |    |   |   |   |   |   |   |
| 6  | 13 | 17 | 16 | 15 | 14 | 18 |   |   |   |   |   |   |
| 7  |    |    |    |    |    |    |   |   |   |   |   |   |
| 8  | 19 | 20 | 21 | 22 | 23 | 24 |   |   |   |   |   |   |
| 9  |    |    |    |    |    |    |   |   |   |   |   |   |
| 10 | 30 | 29 | 28 | 27 | 26 | 25 |   |   |   |   |   |   |
| 11 |    |    |    |    |    |    |   |   |   |   |   |   |
| 12 | 31 | 32 | 33 | 34 | 35 | 36 |   |   |   |   |   |   |
| 13 |    |    |    |    |    |    |   |   |   |   |   |   |

A. Description of original monument and accessories and/or subsequent restoration:

Set post in 1816 G.L.O. Survey.  
There is one LCRC recorded at Oakland County; Albright 1976.

B. Description of corner evidence found and/or method applied in restoring or reestablishing corner:

Recovered a 5/8" Iron in monument box in Hickory Ridge Road at this location. Could not recover any witnesses of the above referenced LCRC. No local monumentation was present to substantiate the monument box therefore we recommend accepting it as is.

Recovered Witnesses:

S 61°W 35.41' Found nail north side 12" Elm.


C. Description of monument for corner and accessories established to perpetuate locating the position of the corner:

Set Oakland County Remonumentation Brass Cap stamped #24598 in the existing monument box.

Set Witnesses:

N 40°W 53.09' Mag nail with OCRT #24598 northeast side 10" Elm.  
S 61°W 35.35' Mag nail with OCRT #24598 north side 12" Elm.  
S 19°E 71.31' Mag nail with OCRT #24598 west side 36" Oak.  
S 73°E 37.52' Mag nail with OCRT #24598 west side 12" Pine.

2p  
12

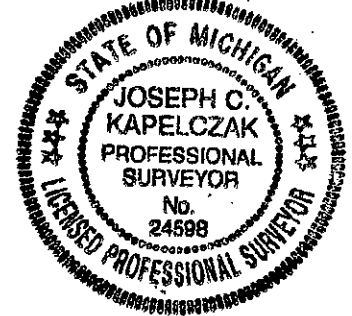

Signed by Joseph C. Kapelczak  
Surveyor's Michigan License No. 24598

Date 10/12/99