

MAY 24 2000

LAND CORNER RECORDATION CERTIFICATE  
Filing Requirement of Act 74, Mich. P.A. 1970

374940

SECTION  
For corners in

<u>Oakland</u> (county)	Located in: Rose Township	Corner Code # D-9
1. Public Land Survey	T4N R7E	D-9
	T R	
	T R	
	T R	
2. Property Controlling in Section	S T R	
	S T R	
3. Miscellaneous Property in Sec.	S T R	
	S T R	

LIBER 20657 PAGE 316  
\$9.00 MISC RECORDING  
\$2.00 REMONUMENTATION  
10/12/1999 08:06:33 A.M. RECEIPT# 889  
PAID RECORDED - OAKLAND COUNTY  
G. WILLIAM CADDELL, CLERK/REGISTER OF

Compliance with  
ACT 345, P.A. 1990

APPROVED ON: 5-5-99 JS  
OAKLAND COUNTY REMONUMENTATION  
PEER GROUP COMMITTEE

Register of Deeds Stamp & File Number

4. Lot No. \_\_\_\_\_, Recorded Plat \_\_\_\_\_

5. Private Claims \_\_\_\_\_

I, Joseph C. Kapelczak, in a field survey on April 11, 1998, do hereby certify that under requirements of P.A. 74, Michigan P.A. of 1970, the corner points mentioned in lines 1 and 2 above were in conformance with regulations and rules therefore as required in the current manual of survey instructions of the United States Department of the Interior, Bureau of Land Management or by a decree of a Court of Law and/or that the corner points mentioned in lines 3, 4 and 5 above were in conformance with the rules of the Michigan Board of Land Surveyors or by a Decree of a Court of Law, established, re-established, monumented, re-monumented, recovered, found as expressed below:

NOTE: Not more than 4 corners, all in the same town and range, may be recorded on this certificate.

A. Description of original monument and accessories and/or subsequent restoration:

Set post in 1816 G.L.O. Survey.  
There are three LCRC's recorded at Oakland County; Albright 1978, Ward 1986 and Bonno 1988.

B. Description of corner evidence found and/or method applied in restoring or reestablishing corner:

Recovered a 5/8" iron in DeMode Road at this location. This location was validated with monumentation recovered along the R.O.W. of DeMode Road east and west of Section Corner along with recovered witnesses in the recorded LCRC's.

\*Recovered Witnesses:

- \*S 06°W 27.61' nail with tag #32332 east side 12" Box Elder.
- S 06°W 27.90' nail with Grant Ward tag west side 12" Box Elder.
- \*S 43°W 32.92' nail with tag #32332 east side 10" Box Elder.
- \*N 70°E 71.83' nail with tag #32332 south side 10" Thorn Apple.
- \*S 80°E 99.17' nail with tag #32332 north side 10" Shag Bark Hickory.
- S 80°E 99.17' nail with Grant Ward tag north side 10" Shag Bark Hickory.


C. Description of monument for corner and accessories established to perpetuate locating the position of the corner:

Set 5/8" iron with Oakland County Remonumentation Brass Cap stamped #24598 in gravel road.

Set Witnesses:

- South 40.18' Mag nail with OCRT#2598 west side 12" Shag Bark Hickory.
- \*S 43°W 33.24' Mag nail with OCRT #24598 east side 10" Box Elder.
- N 05°W 57.99' Mag nail with OCRT #24598 west side power pole.
- \*N 70°E 71.83' Mag nail with OCRT #24598 south side 10" Thorn Apple.

\*Reused Recovered Witness

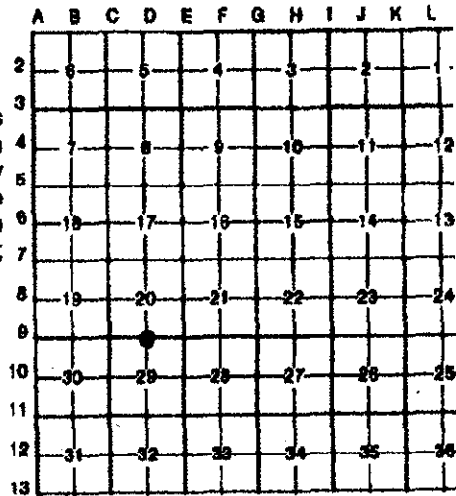

Signed by Joseph C. Kapelczak  
Surveyor's Michigan License No. 24598

Date 5/5/99