

MAY 24 2000

LAND CORNER RECORDATION CERTIFICATE
Filing Requirement of Act 74, Mich. P.A. 1970

374941

SECTION

For corners in

<u>Oakland</u> (county)	Located In:	Comer Code #
	Rose Township	
1. Public Land Survey	T4N R7E	D-11
	T___ R___	_____
	T___ R___	_____
	T___ R___	_____
2. Property Controlling in Section	S___ T___	_____
	S___ T___	_____
3. Miscellaneous Property in Sec.	S___ T___	_____
	S___ T___	_____

LIBER 20657 PAGE 318
\$9.00 MISC RECORDING
\$2.00 REMONUMENTATION
10/12/1999 08:06:33 A.M. RECEIPT# 889
PAID RECORDED - OAKLAND COUNTY
G. WILLIAM CADDELL, CLERK/REGISTER OF

Compliance with
ACT 345, P.A. 1990

APPROVED ON: 7-7-99 JS
OAKLAND COUNTY REMONUMENTATION
PEER GROUP COMMITTEE

Register of Deeds Stamp & File Number

4. Lot No. _____, Recorded Plat _____

5. Private Claims _____

I, Joseph C. Kapelczak, in a field survey on April 3, 1998, do hereby certify that under requirements of P.A. 74, Michigan P.A. of 1970, the corner points mentioned in lines 1 and 2 above were in conformance with regulations and rules therefore as required in the current manual of survey instructions of the United States Department of the Interior, Bureau of Land Management or by a decree of a Court of Law and/or that the corner points mentioned in lines 3, 4 and 5 above were in conformance with the rules of the Michigan Board of Land Surveyors or by a Decree of a Court of Law, established, re-established, monumented, re-monumented, recovered, found as expressed below:

	A	B	C	D	E	F	G	H	I	J	K	L	N
2	6	5	4	3	2	1							
3													
4	7	8	9	10	11	12							
5													
6	18	17	16	15	14	13							
7													
8	19	20	21	22	23	24							
9													
10	30	29	28	27	26	25							
11													
12	31	32	33	34	35	36							
13													

NOTE: Not more than 4 corners, all in the same town and range, may be recorded on this certificate.

A. Description of original monument and accessories and/or subsequent restoration:

Set post in 1816 G.L.O. Survey.
There are three LCRC's recorded at Oakland County; Albright 1974, Bonno 1992 and Bonno 1992.

B. Description of corner evidence found and/or method applied in restoring or reestablishing corner:

Recovered a "T" iron at this location. Validated location with witnesses recovered from Albright, 1974 L 6373 P 862 and Bonno 1992, L 15305 P 876.

Recovered Witnesses:

- *N 30°E 67.92' nail 8" Maple.
- *S 10°E 34.91' nail west side 12" Pine (dead)
- *S 60°W 5.85' nail south side 12" Pine (dead)
- *S 87°E 6.86' nail south side 8" White Birch
- *North 39.90' nail west side quad 8" Maple.


C. Description of monument for comer and accessories established to perpetuate locating the position of the corner:

Set Oakland County Remonumentation Brass Cap stamped #24598 on existing iron.

Set Witnesses:

- S 80°W 9.38' nail with OCRT #24598 south side 12" Maple.
- S 15°E 27.36' nail with OCRT #24598 west side 6" Birch.
- *S 87°E 6.86' nail with OCRT #24598 south side 8" Birch.
- *North 39.91' nail with OCRT #24598 west side quad 8" Maple.

*Reused Recovered Witnesses

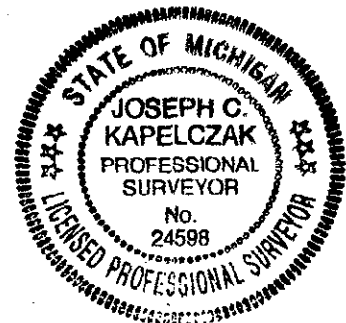

20
R

Signed by Joseph C. Kapelczak
Surveyor's Michigan License No. 24598

Date 7/8/99