

MAY 24 2000

LAND CORNER RECORDATION CERTIFICATE  
Filing Requirement of Act 74, Mich. P.A. 1970

374942

LIBER 20657 PAGE 320  
\$9.00 MISC RECORDING  
\$2.00 REMONUMENTATION  
10/12/1999 08:06:33 A.M. RECEIPT# 88906  
PAID RECORDED - OAKLAND COUNTY  
G. WILLIAM CADDELL, CLERK/REGISTER OF DEEDS

SECTION

For corners in

Oakland (county)	Located In: Rose Township	Corner Code #
1. Public Land Survey	T4N R7E	E-6
	T R	
	T R	
	T R	
2. Property Controlling in Section	S T R	
	S T R	
3. Miscellaneous Property in Sec.	S T R	
	S T R	

Compliance with  
ACT 345, P.A. 1990  
APPROVED ON: 4-21-99 JS  
OAKLAND COUNTY REMONUMENTATION  
PEER GROUP COMMITTEE  
Register of Deeds Stamp & File Number

4. Lot No. \_\_\_\_\_, Recorded Plat \_\_\_\_\_  
5. Private Claims \_\_\_\_\_

I, Joseph C. Kapelczak, in a field survey on March 16, 1998, do hereby certify that under requirements of P.A. 74, Michigan P.A. of 1970, the corner points mentioned in lines 1 and 2 above were in conformance with regulations and rules therefore as required in the current manual of survey instructions of the United States Department of the Interior, Bureau of Land Management or by a decree of a Court of Law and/or that the corner points mentioned in lines 3, 4 and 5 above were in conformance with the rules of the Michigan Board of Land Surveyors or by a Decree of a Court of Law; established, re-established, monumented, re-monumented, recovered, found as expressed below:

	A	B	C	D	E	F	G	H	I	J	K	L	M
2													
3													
NOTE: Not more than 4 corners, all in the same town and range, may be recorded on this certificate.

A. Description of original monument and accessories and/or subsequent restoration:  
Set post in 1816 G.L.O. Survey.  
There is one LCRC recorded at Oakland County; Hart 1995.


B. Description of corner evidence found and/or method applied in restoring or reestablishing corner:  
Recovered a 1/2" iron in Fish Lake Road at this location. Validated this location with monumentation recovered along R.O.W. on west side of Fish Lake Road south of corner.

Recovered Witnesses:  
\*N 64°W 35.55' nail south side 12" Ash.  
\*S 11°E 113.58' nail west side 20" Walnut.  
\*S 13°W 77.16' nail with tag #10057 east side 40" Oak.

C. Description of monument for corner and accessories established to perpetuate locating the position of the corner:  
Set 5/8" iron with Oakland County Remonumentation Brass Cap stamped #24598 in gravel road.

Set Witnesses:  
N 60°E 39.26' nail with OCRT #24598 top of fence post.  
N 64°W 35.55' nail with OCRT #24598 south side 12" Ash.  
S 11°E 113.98' nail with OCRT #24598 west side 20" Walnut  
S 13°W 77.16' nail with OCRT #24598 east side 40" Oak.

\*Reused Recovered Witness

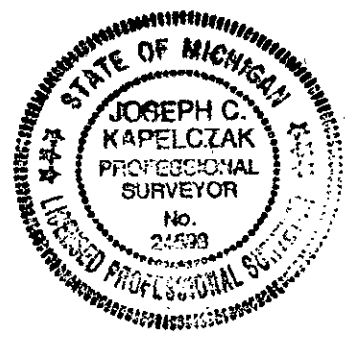

Signed by Joseph C. Kapelczak Date 4/16/99  
Surveyor's Michigan License No. 24598