

MAY 24 2000

LAND CORNER RECORDATION CERTIFICATE  
Filing Requirement of Act 74, Mich. P.A. 1970

374944

SECTION

For corners in

Oakland (county)	Located in: Rose Township	Corner Code #
1. Public Land Survey	T4N R7E	E-8
	T R	
	T R	
	T R	
2. Property Controlling in Section	S T R	
	S T R	
3. Miscellaneous Property in Sec.	S T R	
	S T R	

LIBER 20657 PAGE 324  
\$9.00 MISC RECORDING  
\$2.00 REMONUMENTATION  
10/12/1999 08:06:33 A.M. RECEIPT# 88906  
PAID RECORDED - OAKLAND COUNTY  
G. WILLIAM CADDELL, CLERK/REGISTER OF DEEDS

Compliance with  
ACT 345, P.A. 1990

APPROVED ON: 5-5-99 JS  
OAKLAND COUNTY REMONUMENTATION  
PEER GROUP COMMITTEE  
Register of Deeds Stamp & File Number

4. Lot No. \_\_\_\_\_, Recorded Plat \_\_\_\_\_

5. Private Claims \_\_\_\_\_

I, Joseph C. Kapelczak, in a field survey on April 1, 1998, do hereby certify that under requirements of P.A. 74, Michigan P.A. of 1970, the corner points mentioned in lines 1 and 2 above were in conformance with regulations and rules therefore as required in the current manual of survey instructions of the United States Department of the Interior, Bureau of Land Management or by a decree of a Court of Law and/or that the corner points mentioned in lines 3, 4 and 5 above were in conformance with the rules of the Michigan Board of Land Surveyors or by a Decree of a Court of Law, established, re-established, monumented, re-monumented, recovered, found as expressed below:

A	B	C	D	E	F	G	H	I	J	K	L
2	6	5	4	3	2	1					
3											
4	7	8	9	10	11	12					
5											
6	13	14	15	16	17	18					
7											
8	19	20	21	22	23	24					
9											
10	25	26	27	28	29	30					
11											
12	31	32	33	34	35	36					
13											

NOTE: Not more than 4 corners, all in the same town and range, may be recorded on this certificate.

A. Description of original monument and accessories and/or subsequent restoration:

Set post in 1816 G.L.O. Survey.  
There are two LCRC's recorded at Oakland County; Albright 1973, and Scharl 1978.

B. Description of corner evidence found and/or method applied in restoring or reestablishing corner:

Recovered 1/2" iron in Fish Lake Road at this location. This location was validated with monumentation recovered along the R.O.W. lines of Fish Lake Road, along with recovered witnesses of both recorded LCRC's.

Recovered Witnesses:

- \*N 55°E 23.35' nail northwest side 18" Oak.
- \*N 90°E 31.24' nail south side 14" Oak.
- \*N 40°W 22.71' nail northeast side 10" Oak.
- N 40°W 21.45' nail southeast side 10" Oak.
- N 85°W 33.40' nail south side power pole.
- N 85°W 32.55' nail with tag #10057 southeast side power pole.


C. Description of monument for corner and accessories established to perpetuate locating the position of the corner:

Set 5/8" iron with Oakland County Remonumentation Brass Cap stamped #24598 in gravel road.

Set Witnesses:

- S 08°E 96.64' Mag nail with OCRT #24598 west side Twin 32" Oak.
- \*N 55°E 23.35' Mag nail with OCRT #24598 northwest side 18" Oak.
- East 31.24' Mag nail with OCRT #24598 south side 14" Oak.
- \*N 40°W 21.45' Mag nail with OCRT #24598 southeast side 10" Oak.
- N 85°W 32.55' Mag nail with OCRT #24598 southeast side power pole.

\*Reused Recovered Witnesses

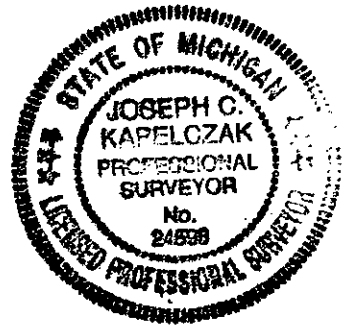

Signed by Joseph C. Kapelczak

Date 5/1/99

Surveyor's Michigan License No. 24598