

MAY 24 2000

LIBER 19843PG649

SECTION

LAND CORNER RECORDATION CERTIFICATE
Filing Requirement of Act 74, Mich. P.A. 1970

131647

For corners in

Oakland (county)	Located in: Rose Township	Corner Code #
1. Public Land Survey	T4N R7E	E-13
	T R	
	T R	
	T R	
2. Property Controlling in Section	S T R	
	S T R	
3. Miscellaneous Property in Sec.	S T R	
	S T R	

LIBER 19843 PAGE 649
\$9.00 MISC RECORDING
\$2.00 REMONUMENTATION
04/16/1999 08:59:50 A.M. RECEIPT# 19968
PAID RECORDED - OAKLAND COUNTY
G. WILLIAM CADDELL, CLERK/REGISTER OF DEEDS

Compliance with
ACT 345, P.A. 1990

APPROVED ON: 3-18-99 JS
OAKLAND COUNTY REMONUMENTATION
PEER GROUP COMMITTEE

Register of Deeds Stamp & File Number

4. Lot No. _____, Recorded Plat _____

5. Private Claims _____

I, Joseph C. Kapelczak, in a field survey on December 21, 1998, do hereby certify that under requirements of P.A. 74, Michigan P.A. of 1970, the corner points mentioned in lines 1 and 2 above were in conformance with regulations and rules therefore as required in the current manual of survey instructions of the United States Department of the Interior, Bureau of Land Management or by a decree of a Court of Law and/or that the corner points mentioned in lines 3, 4 and 5 above were in conformance with the rules of the Michigan Board of Land Surveyors or by a Decree of a Court of Law; established, re-established, monumented, re-monumented, recovered, found as expressed below:

	A	B	C	D	E	F	G	H	I	J	K	L
2	6	5	4	3	2	1						
3												
4	7	8	9	10	11	12						
5												
6	16	17	18	15	14	13						
7												
8	19	20	21	22	23	24						
9												
10	30	29	28	27	26	25						
11												
12	31	32	33	34	35	36						
13												

NOTE: Not more than 4 corners, all in the same town and range, may be recorded on this certificate.

A. Description of original monument and accessories and/or subsequent restoration:

Set post in 1816 G.L.O. Survey.
There are two LCRC's recorded at Oakland County; Albright 1977 and Bonno 1990.

B. Description of corner evidence found and/or method applied in restoring or reestablishing corner:

Recovered a capped iron at this location. This location was validated with monumentation recovered from Tri-County Survey of both Sections 32 & 33 and along south township line.

Recovered Witnesses:

*N 88°E 22.58' nail north side fence post.


C. Description of monument for corner and accessories established to perpetuate locating the position of the corner:

Set concrete monument with Oakland County Remonumentation Brass Cap stamped #24598.

Set Witnesses:

*N 88°E 22.58' Mag nail with OCRT #24598 north side fence post.
N 44°W 6.43' Mag nail with OCRT #24598 north side 8" Hickory.
N 75°W 28.59' Mag nail with OCRT #24598 north side 8" Pine.
N 15°W 46.93' Mag nail with OCRT #24598 north side 3" Maple.
S 87°27'00"W 158.88' iron in monument box E-1 Highland Township.

*Reused Recovered Witness

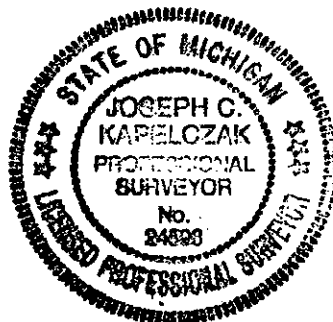

Signed by Joseph C. Kapelczak

Date 3/17/99

Surveyor's Michigan License No. 24598