

MAY 24 2000

LAND CORNER RECORDATION CERTIFICATE
Filing Requirement of Act 74, Mich. P.A. 1970

374950

For corners in

<u>Oakland</u> (county)	Located in:	Corner Code #
	Rose Township	
1. Public Land Survey	T4N R7E	F-7
	T R	
	T R	
	T R	
2. Property Controlling in Section	S T R	
	S T R	
3. Miscellaneous Property in Sec.	S T R	
	S T R	

LIBER 20657 PAGE 336
 \$9.00 MISC RECORDING
 \$2.00 REMONUMENTATION
 10/12/1999 08:06:33 A.M. RECEIPT# 88906
 PAID RECORDED - OAKLAND COUNTY
 G. WILLIAM CADDELL, CLERK/REGISTER OF DEEDS

Compliance with
 ACT 345, P.A. 1990

APPROVED ON: 4-21-99 JS
 OAKLAND COUNTY REMONUMENTATION
 PEER GROUP COMMITTEE

Register of Deeds Stamp & File Number

4. Lot No. _____, Recorded Plat _____

5. Private Claims _____

I, Joseph C. Kapelczak, in a field survey on October 7, 1998, do hereby certify that under requirements of P.A. 74, Michigan P.A. of 1970, the corner points mentioned in lines 1 and 2 above were in conformance with regulations and rules therefore as required in the current manual of survey instructions of the United States Department of the Interior, Bureau of Land Management or by a decree of a Court of Law and/or that the corner points mentioned in lines 3, 4 and 5 above were in conformance with the rules of the Michigan Board of Land Surveyors or by a Decree of a Court of Law, established, re-established, monumented, re-monumented, recovered, found as expressed below:

A	B	C	D	E	F	G	H	I	J	K	L
2	6	5	4	3	2	1					
3											
4	7	8	9	10	11	12					
5											
6	13	14	15	16	17	18					
7											
8	19	20	21	22	23	24					
9											
10	25	26	27	28	29	30					
11											
12	31	32	33	34	35	36					
13											

NOTE: Not more than 4 corners, all in the same town and range, may be recorded on this certificate.

A. Description of original monument and accessories and/or subsequent restoration:

Set post in 1816 G.L.O. Survey.
 There is one LCRC recorded at Oakland County; Albright 1978.

B. Description of corner evidence found and/or method applied in restoring or reestablishing corner:

Recovered a mini PK nail in driveway of house #1395 Beaver Brook Road at this location. This location was validated with monumentation recovered in Cambridge Hills Subdivision and Cambridge Acres Subdivision along with three recovered witnesses from the recorded LCRC.

Recovered Witnesses:


- *N 10°E 85.07' Double-headed nail with tag #17623 west side power pole.
- *N 10°E 84.76' nail west side power pole.
- N 10°E 84.76' nail west side power pole.
- *S 72°E 25.07' PK nail with tag #17623 north side 34" Oak.
- *S 22°W 25.09' nail with tag #10057 west side 15" Cherry.

C. Description of monument for corner and accessories established to perpetuate locating the position of the corner:

Set 5/8" Iron rod with Oakland County Remonumentation Brass Cap stamped #24598 in asphalt driveway.

- N 88°W 19.92' Mag nail with OCRT #24598 north side 12" Oak.
- *N 10°E 85.07' Mag nail with OCRT #24598 west side power pole.
- *S 72°E 25.07' Mag nail with OCRT #24598 north side 34" Oak.
- *S 22°W 25.09' Mag nail with OCRT #24598 west side 15" Cherry.

*Reused Recovered Witnesses

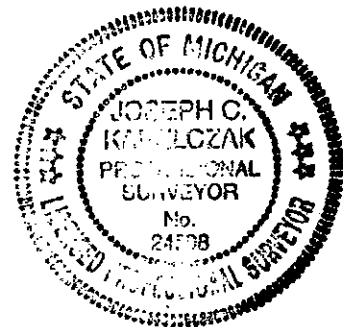

Signed by Joseph C. Kapelczak

Date 4/20/99

Surveyor's Michigan License No. 24598