

MAY 24 2000

LAND CORNER RECORDATION CERTIFICATE  
Filing Requirement of Act 74, Mich. P.A. 1970

374951

SECTION

LIBER 20657 PAGE 338  
\$9.00 MISC RECORDING  
\$2.00 REMONUMENTATION  
10/12/1999 08:06:33 A.M. RECEIPT# 88906  
PAID RECORDED - OAKLAND COUNTY  
G. WILLIAM CADDELL, CLERK/REGISTER OF DEEDS

Compliance with  
ACT 74, P.A. 1990

APPROVED ON: 5-5-99 55  
OAKLAND COUNTY REMONUMENTATION  
PEER GROUP COMMITTEE

Register of Deeds Stamp & File Number

For corners in

<u>Oakland</u> (county)	Located In:	Corner Code #
	Rose Township	
1. Public Land Survey	T <u>4N</u> R <u>7E</u>	<u>F-9</u>
	T___ R___	_____
	T___ R___	_____
	T___ R___	_____
2. Property Controlling in Section	S___ T___ R___	_____
	S___ T___ R___	_____
3. Miscellaneous Property in Sec.	S___ T___ R___	_____
	S___ T___ R___	_____

4. Lot No. \_\_\_\_\_ Recorded Plat \_\_\_\_\_

5. Private Claims \_\_\_\_\_

I, Joseph C. Kapelczak, in a field survey on April 16, 1998, do hereby certify that under requirements of P.A. 74, Michigan P.A. of 1970, the corner points mentioned in lines 1 and 2 above were in conformance with regulations and rules therefore as required in the current manual of survey instructions of the United States Department of the Interior, Bureau of Land Management or by a decree of a Court of Law and/or that the corner points mentioned in lines 3, 4 and 5 above were in conformance with the rules of the Michigan Board of Land Surveyors or by a Decree of a Court of Law, established, re-established, monumented, re-monumented, recovered, found as expressed below.

NOTE: Not more than 4 corners, all in the same town and range, may be recorded on this certificate.

A. Description of original monument and accessories and/or subsequent restoration:

Set post in 1816 G.L.O. Survey.  
There are four LCRC's recorded at Oakland County; Albright 1973, McMahon 1977, McMahon 1979, and Thompson 1991.

B. Description of corner evidence found and/or method applied in restoring or reestablishing corner:

Recovered a 1/2" iron in DeMode Road at this location. This location was validated with monumentation recovered along the R.O.W. of DeMode Road and witnesses in the recorded LCRC's.

\*Recovered Witnesses:

- \*N 80°E 81.40' double-headed nail with tag #39075 south side quad 15" Hickory.
- \*N 60°W 28.66' double-headed nail with tag #39075 south side 12" Willow.
- \*S 60°W 57.95' double-headed nail with tag #39075 north side 8" Poplar.


C. Description of monument for corner and accessories established to perpetuate locating the position of the corner:

Set 5/8" iron rod with Oakland County Remonumentation Brass Cap stamped #24598 in gravel road.

Set Witnesses:

- N 10°W 67.23' Mag nail with OCRT #24598 east side 14" Oak.
- \*N 80°E 81.40' Mag nail with OCRT #24598 south side quad 15" Hickory.
- \*N 60°W 28.66' Mag nail with OCRT #24598 south side 12" Willow.
- \*S 60°W 57.95' Mag nail with OCRT #24598 north side 8" Poplar.

	A	B	C	D	E	F	G	H	I	J	K	L
2			5		4			3		2		
3												
4	7		8		9			10		11		
5												
6	16		17		18			15		14		
7												
8	19		20		21			22		23		
9												
10	30		29		28			27		26		
11												
12	31		32		33			34		35		
13												

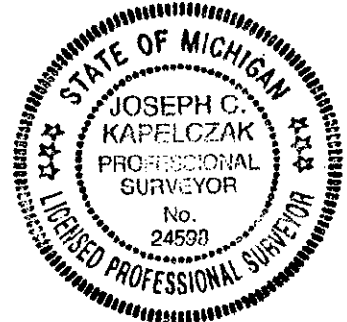

Signed by Joseph C. Kapelczak  
Surveyor's Michigan License No. 24598

Date 5/15/99