

MAY 24 2000

LAND CORNER RECORDATION CERTIFICATE
Filing Requirement of Act 74, Mich. P.A. 1970

374952

LIBER 20657 PAGE 340
\$9.00 MISC RECORDING
\$2.00 REMONUMENTATION
10/12/1999 08:06:33 A.M. RECEIPT# 88906
PAID RECORDED - OAKLAND COUNTY
G. WILLIAM CADDELL, CLERK/REGISTER OF DEEDS

SECTION

For corners in

<u>Oakland</u> (county)	Located In: Rose Township	Corner Code # F-11
1. Public Land Survey	T4N R7E	F-11
	T R	
	T R	
	T R	
2. Property Controlling in Section	S T R	
	S T R	
3. Miscellaneous Property in Sec.	S T R	
	S T R	

Compliance with
ACT 345, P.A. 1990
APPROVED ON: 7-7-99 JK
OAKLAND COUNTY REMONUMENTATION
PEER GROUP COMMITTEE
Register of Deeds Stamp & File Number

4. Lot No. _____, Recorded Plat _____

5. Private Claims _____

I, Joseph C. Kapelczak, in a field survey on April 3, 1998, do hereby certify that under requirements of P.A. 74, Michigan P.A. of 1970, the corner points mentioned in lines 1, and 2 above were in conformance with regulations and rules therefore as required in the current manual of survey instructions of the United States Department of the Interior, Bureau of Land Management or by a decree of a Court of Law and/or that the corner points mentioned in lines 3, 4 and 5 above were in conformance with the rules of the Michigan Board of Land Surveyors or by a Decree of a Court of Law; established, re-established, monumented, re-monumented, recovered, found as expressed below:

	A	B	C	D	E	F	G	H	I	J	K	L
2	6	5	4	3	2	1						
3												
4	7	8	9	10	11	12						
5												
6	16	17	18	15	14	13						
7												
8	19	20	21	22	23	24						
9												
10	30	29	28	27	26	25						
11												
12	31	32	33	34	35	36						
13												

NOTE: Not more than 4 corners, all in the same town and range, may be recorded on this certificate.

A. Description of original monument and accessories and/or subsequent restoration:

Set post in 1816 G.L.O. Survey.
There is one LCRC recorded at Oakland County; Boss 1976.

B. Description of corner evidence found and/or method applied in restoring or reestablishing corner:

Recovered a 5/8" pipe at this location. Validated location with monumentation recovered from a Boss Engineering Survey in Section 28 along with a witness recovered in the above LCRC.

Recovered Witnesses:

- N45°W 31.59' nail west side 10" Poplar
- N 45°E 49.83' nail with tag #39075 west side 30" Tamarak
- S 03°E 16.64' nail with tag #39075 west side 10" Poplar
- S 15°W 42.8880' nail with tag #39075 east side 14" Poplar
- S 85°W 38.83' nail with tag #39075 north side Twin 8" Oak


2p
R

C. Description of monument for corner and accessories established to perpetuate locating the position of the corner:

Set concrete monument with Oakland County Remonumentation Brass Cap stamped #24598.

Set Witnesses:

- N 30°E 47.59' nail with OCRT #24598 east side 8" Oak.
- S 03°E 16.64' nail with OCRT #24598 west side 10" Poplar.
- S 85°W 38.83' nail with OCRT #24598 north side Twin 10" Oak.
- N 50°W 38.46' nail with OCRT #24598 east side 8" Poplar.

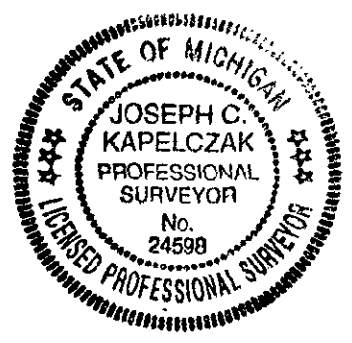

Signed by Joseph C. Kapelczak
Surveyor's Michigan License No. 24598

Date 6/26/99