

MAY 24 2000

LIBER 19843 PG 671

SECTION

LAND CORNER RECORDATION CERTIFICATE
Filing Requirement of Act 74, Mich. P.A. 1970

For corners in

Oakland (county)	Located In: Rose Township	Corner Code #
1. Public Land Survey	T4N R7E	F-13
	T R	
	T R	
	T R	
2. Property Controlling in Section	S T R	
	S T R	
3. Miscellaneous Property in Sec.	S T R	
	S T R	

131658

LIBER 19843 PAGE 671
\$9.00 MISC RECORDING
\$2.00 REMONUMENTATION
04/16/1999 08:59:50 A.M. RECEIPT# 19968
PAID RECORDED - OAKLAND COUNTY
G. WILLIAM CADDELL, CLERK/REGISTER OF DEEDS
Compliance with
ACT 345, P.A. 1990

APPROVED ON: 3-31-99 JS
OAKLAND COUNTY REMONUMENTATION
PEER GROUP COMMITTEE

Register of Deeds Stamp & File Number

4. Lot No. _____ Recorded Plat _____

5. Private Claims _____

I, Joseph C. Kapelczak, in a field survey on April 16, 1999, do hereby certify that under requirements of P.A. 74, Michigan P.A. of 1970, the corner points mentioned in lines 1 and 2 above were in conformance with regulations and rules therefore as required in the current manual of survey instructions of the United States Department of the Interior, Bureau of Land Management or by a decree of a Court of Law and/or that the corner points mentioned in lines 3, 4 and 5 above were in conformance with the rules of the Michigan Board of Land Surveyors or by a Decree of a Court of Law; established, re-established, monumented, re-monumented, recovered, found as expressed below:

NOTE: Not more than 4 corners, all in the same town and range, may be recorded on this certificate.

	A	B	C	D	E	F	G	H	I	J	K	L	I
2	6		5		4		3		2		1		
3													
4	7		8		9		10		11		12		
5													
6	16		17		18		19		20		21		
7													
8	18		20		21		22		23		24		
9													
10	30		29		28		27		26		25		
11													
12	31		32		33		34		35		36		
13													

A. Description of original monument and accessories and/or subsequent restoration:

Set post in 1816 G.L.O. Survey.
There are no LCRC's recorded at Oakland County.

B. Description of corner evidence found and/or method applied in restoring or reestablishing corner:

Recovered a 1/2" iron at this location. This location was validated with monumetation recovered from 1977 Pike Survey in Section 33. This location also agrees with an iron found at the southeast corner of Parcel 6-33-451-005.

Recovered Witnesses:


Found downed tree stump with nail @ N 45°W 14.51' ±
N 08°W 11.17' nail east side 22" Oak
N 50°E 3.48' nail northwest side 24" stump

C. Description of monument for corner and accessories established to perpetuate locating the position of the corner:

Set concrete monument with Oakland County Remonumentation Cap stamped #24598.

Set Witnesses:

N 79°W 7.87' PK with OCRT #24598 north side 16" Oak
N 08°W 11.17' PK with OCRT #24598 east side 22" Oak
N 48°E 14.88' Mag nail with OCRT #24598 northwest side 10" Cherry
S 45°E 10.52' Mag nail with OCRT #24598 west side 6" Elm

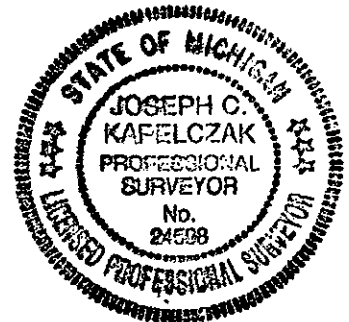

Signed by Joseph C. Kapelczak

Date 3/20/99

Surveyor's Michigan License No. 24598