

MAY 24 2000

LIBER 20657 312

SECTION

LAND CORNER RECORDATION CERTIFICATE
Filing Requirement of Act 74, Mich. P.A. 1970

374953

For comers in

<u>Oakland</u> (county)	Located In:	Corner Code #
	Rose Township	
1. Public Land Survey	T <u>4</u> N R <u>7</u> E	<u>G-1</u>
	T _____ R _____	_____
	T _____ R _____	_____
	T _____ R _____	_____
2. Property Controlling in Section	S _____ T _____	_____
	S _____ T _____	_____
3. Miscellaneous Property in Sec.	S _____ T _____	_____
	S _____ T _____	_____

LIBER 20657 PAGE 342
 \$9.00 MISC RECORDING
 \$2.00 REMONUMENTATION
 10/12/1999 08:06:33 A.M. RECEIPT# 88906
 PAID RECORDED - OAKLAND COUNTY
 G. WILLIAM CADDELL, CLERK/REGISTER OF DEED

Compliance with
 ACT 345, P.A. 1990

APPROVED ON: 9-29-99 JIL
 OAKLAND COUNTY REMONUMENTATION
 PEER GROUP COMMITTEE

Register of Deeds Stamp & File Number

4. Lot No. _____, Recorded Plat _____

5. Private Claims _____

I, Joseph C. Kapelczak, in a field survey on April 22, 1998, do hereby certify that under requirements of P.A. 74, Michigan P.A. of 1970, the corner points mentioned in lines 1 and 2 above were in conformance with regulations and rules therefore as required in the current manual of survey instructions of the United States Department of the Interior, Bureau of Land Management or by a decree of a Court of Law and/or that the corner points mentioned in lines 3, 4 and 5 above were in conformance with the rules of the Michigan Board of Land Surveyors or by a Decree of a Court of Law, established, re-established, monumented, re-monumented, recovered, found as expressed below:

	A	B	C	D	E	F	G	H	I	J	K	L
2	8		5		4		3		2		1	
3												
4	7		6		5		4		3		2	
5												
6	16		17		18		15		14		13	
7												
8	19		20		21		22		23		24	
9												
10	30		29		28		27		26		25	
11												
12	31		32		33		34		35		36	
13												

NOTE: Not more than 4 corners, all in the same town and range, may be recorded on this certificate.

A. Description of original monument and accessories and/or subsequent restoration:

Set post in 1816 G.L.O. Survey.
 There are no LCRC's recorded at Oakland County.

B. Description of corner evidence found and/or method applied in restoring or reestablishing corner:

Recovered a "T" iron 0.10' south of the Holly Township line and 46.53' west of G-13, Holly Township. This location was validated with monumentation recovered along the north township line in Sections 3 & 4.


C. Description of monument for corner and accessories established to perpetuate locating the position of the corner:

Set concrete monument with Oakland County Remonumentation Brass Cap #24598 on Township line.

Set Witnesses:

- N 64°W 23.04' Mag nail with OCRT #24598 east side 12" Box Elder.
- S 29°W 66.44' Mag nail with OCRT #24598 east side 3" Box Elder.
- S 22°W 109.45' Mag nail with OCRT #24598 east side 12" Box Elder.
- S 12°W 181.79' Mag nail with OCRT #24598 east side 7" Poplar.

2p
R

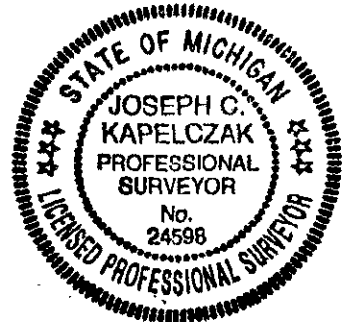

Signed by Joseph C. Kapelczak
 Surveyor's Michigan License No. 24598

Date 9/27/99