

MAY 24 2000

LAND CORNER RECORDATION CERTIFICATE
Filing Requirement of Act 74, Mich. P.A. 1970

374962

SECTION

For corners in

<u>Oakland</u> (county)	Located in: Rose Township	Corner Code # _____
1. Public Land Survey	T <u>4N</u> R <u>7E</u>	<u>H-9</u>
	T _____ R _____	_____
	T _____ R _____	_____
	T _____ R _____	_____
2. Property Controlling in Section	S _____ T _____	R _____
	S _____ T _____	R _____
3. Miscellaneous Property in Sec.	S _____ T _____	R _____
	S _____ T _____	R _____

LIBER 20657 PAGE 360
 \$9.00 MISC RECORDING
 \$2.00 REMONUMENTATION
 10/12/1999 08:06:33 A.M. RECEIPT# 88906
 PAID RECORDED - OAKLAND COUNTY
 G. WILLIAM CADDELL, CLERK/REGISTER OF DEEDS

Compliance with
 ACT 35, P.A. 1990

APPROVED ON: 5-26-99 53
 OAKLAND COUNTY REMONUMENTATION
 PEER GROUP COMMITTEE

Register of Deeds Stamp & File Number

4. Lot No. _____, Recorded Plat _____

5. Private Claims _____

I, Joseph C. Kapelczak, in a field survey on February, 1998, do hereby certify that under requirements of P.A. 74, Michigan P.A. of 1970, the corner points mentioned in lines 1 and 2 above were in conformance with regulations and rules therefore as required in the current manual of survey instructions of the United States Department of the Interior, Bureau of Land Management or by a decree of a Court of Law and/or that the corner points mentioned in lines 3, 4 and 5 above were in conformance with the rules of the Michigan Board of Land Surveyors or by a Decree of a Court of Law; established, re-established, monumented, re-monumented, recovered, found as expressed below:

A	B	C	D	E	F	G	H	I	J	K	L
2	0	5	4	3	2	1					
3											
4	7	8	9	10	11	12					
5											
6	16	17	18	15	14	13					
7											
8	19	20	21	22	23	24					
9											
10	30	29	28	27	26	25					
11											
12	31	32	33	34	35	36					
13											

NOTE: Not more than 4 corners, all in the same town and range, may be recorded on this certificate.

A. Description of original monument and accessories and/or subsequent restoration:

Set post in 1816 G.L.O. Survey.
 There is one LCRC recorded at Oakland County; Albright 1972.

B. Description of corner evidence found and/or method applied in restoring or reestablishing corner:

Recovered a 1/2" iron at this location. Also recovered a 7/8" iron pipe 5.74' southeast of the 1/2" iron. The 1/2" iron was validated with witnesses found in the above-referenced LCRC along with monumentation found between H-9 and I-9 and H-9 and H-8.

Recovered Witnesses:

E 28.85' fence post
 NW 24.65' Apple Tree
 SW 64.00' 26" Pine


C. Description of monument for corner and accessories established to perpetuate locating the position of the corner:

Set Oakland County Remonumentation Brass Cap #24598.

Set Witnesses:

N 65°E 22.40' Mag nail with OCRT #24598 south side 12" Box Elder.
 S 70°E 32.40' Mag nail with OCRT #24598 south side 10" Box Elder.
 N30°W 11.20' Mag nail with OCRT #24598 northeast side 7" Box Elder.
 *S 40°W 61.50' Mag nail with OCRT #24598 northeast side 26" Pine.

*Reused Recovered Witness

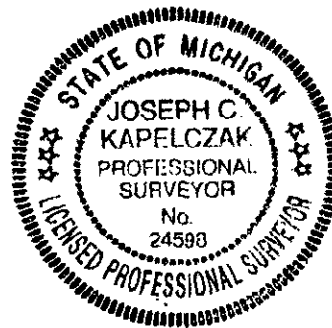

2p
R

Signed by Joseph C. Kapelczak
 Surveyor's Michigan License No. 24598

Date 5/25/99