

MAY 24 2000

LAND CORNER RECORDATION CERTIFICATE  
Filing Requirement of Act 74, Mich. P.A. 1970

374965

SECTION

For corners in

<u>Oakland</u> (county)	Located in: Rose Township	Corner Code #
1. Public Land Survey	T4N R7E	1-6
	T R	
	T R	
	T R	
2. Property Controlling in Section	S T R	
	S T R	
3. Miscellaneous Property in Sec.	S T R	
	S T R	

LIBER 20657 PAGE 366  
\$9.00 MISC RECORDING  
\$2.00 REMONUMENTATION  
10/12/1999 08:06:33 A.M. RECEIPT# 889  
PAID RECORDED - OAKLAND COUNTY  
G. WILLIAM CADDELL, CLERK/REGISTER OF

Compliance with  
ACT 345, P.A. 1990

APPROVED ON: 2-21-99 JS  
OAKLAND COUNTY REMONUMENTATION  
PEER GROUP COMMITTEE  
Register of Deeds Stamp & File Number

4. Lot No. \_\_\_\_\_, Recorded Plat \_\_\_\_\_

5. Private Claims \_\_\_\_\_

I, Joseph C. Kapelczak, in a field survey on March 16, 1998, do hereby certify that under requirements of P.A. 74, Michigan P.A. of 1970, the corner points mentioned in lines 1 and 2 above were in conformance with regulations and rules therefore as required in the current manual of survey instructions of the United States Department of the Interior, Bureau of Land Management or by a decree of a Court of Law and/or that the corner points mentioned in lines 3, 4 and 5 above were in conformance with the rules of the Michigan Board of Land Surveyors or by a Decree of a Court of Law; established, re-established, monumented, re-monumented, recovered, found as expressed below:

	A	B	C	D	E	F	G	H	I	J	K	L	M
2	5	5	4	3	2	1							
3													
4	7	8	9	10	11	12							
5													
6	18	17	16	15	14	13							
7													
8	19	20	21	22	23	24							
9													
10	30	29	28	27	26	25							
11													
12	31	32	33	34	35	36							
13													

NOTE: Not more than 4 corners, all in the same town and range, may be recorded on this certificate.

A. Description of original monument and accessories and/or subsequent restoration:

Set post in 1816 G.L.O. Survey.

There are two LCRC's recorded at Oakland County; Albright 1972 iron, and Ward 1980 iron.

B. Description of corner evidence found and/or method applied in restoring or reestablishing corner:

Recovered a 1/2" iron in Oakhurst Road at this corner. Validated location with monumentation recovered from Reed 1997 survey in Section 15 and monumentation along the R.O.W. line of Oakhurst Road.

Recovered Witnesses:

- \*N 14°E 58.56' nail west side 14" Oak.
- N 18°E 60.25' nail with tag #40162 west side 18" Oak.
- N 84°E 15.32' nail with tag #40162 north side 30" Oak.
- \*N 90°E 15.46' nail south side 30" Oak.
- S 75°W 31.70' nail with tag #40162 north side 12" Maple.
- N 11°W 67.08' nail with tag #40162 east side Twin 12" Maple.

2p  
R


C. Description of monument for corner and accessories established to perpetuate locating the position of the corner:

Set 5/8" iron with Oakland County Remonumentation Brass Cap stamped #24598 in gravel road.

Set Witnesses:

- S 11°W 59.62' Mag nail with OCRT #24598 east side 14" Oak.
- S 75°W 31.70' Mag nail with OCRT #24598 north side 12" Maple.
- \*N 84°E 15.32' Mag nail with OCRT #24598 north side 30" Oak.
- N 18°E 60.25' Mag nail with OCRT #24598 west side 18" Oak.

\*Reused Recovered Witnesses

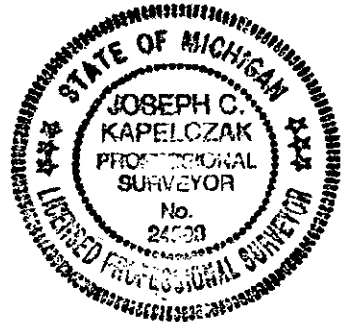

Signed by Joseph C. Kapelczak  
Surveyor's Michigan License No. 24598

Date 4/19/99