

MAY 24 2000

LIBER 20657 PAGE 372

SECTION

LAND CORNER RECORDATION CERTIFICATE  
Filing Requirement of Act 74, Mich. P.A. 1970

374968

For corners in

<u>Oakland</u> (county)	Located in:	Corner Code #
	Rose Township	
1. Public Land Survey	T4N R7E	I-9
	T R	
	T R	
	T R	
2. Property Controlling in Section	S T R	
	S T R	
3. Miscellaneous Property in Sec.	S T R	
	S T R	

LIBER 20657 PAGE 372  
 \$9.00 MISC RECORDING  
 \$2.00 REMONUMENTATION  
 10/12/1999 08:06:33 A.M. RECEIPT# 88906  
 PAID RECORDED - OAKLAND COUNTY  
 G. WILLIAM CADDELL, CLERK/REGISTER OF DEEDS

Compliance with  
ACT 45, P.A. 1990

APPROVED ON: 5-26-99 JS  
 OAKLAND COUNTY REMONUMENTATION  
 PEER GROUP COMMITTEE

Register of Deeds Stamp & File Number

4. Lot No. \_\_\_\_\_, Recorded Plat \_\_\_\_\_

5. Private Claims \_\_\_\_\_

I, Joseph C. Kapelczak, in a field survey on April 22, 1998, do hereby certify that under requirements of P.A. 74, Michigan P.A. of 1970, the corner points mentioned in lines 1 and 2 above were in conformance with regulations and rules therefore as required in the current manual of survey instructions of the United States Department of the Interior, Bureau of Land Management or by a decree of a Court of Law and/or that the corner points mentioned in lines 3, 4 and 5 above were in conformance with the rules of the Michigan Board of Land Surveyors or by a Decree of a Court of Law, established, re-established, monumented, re-monumented, recovered, found as expressed below:

NOTE: Not more than 4 corners, all in the same town and range, may be recorded on this certificate.

A. Description of original monument and accessories and/or subsequent restoration:

Set post in 1816 G.L.O. Survey.  
 There are no LCRC's recorded at Oakland County.

B. Description of corner evidence found and/or method applied in restoring or reestablishing corner:

Recovered a flagged fence post set in concrete at this location. This corner was validated with monumentation found between I-9 and H-9.

\*Recovered Witnesses:

- \*N 55°W 18.28' nail with tag #24607 northeast side 14" Maple.
- \*N 45°E 20.12' nail southeast side 14" Beech.
- \*S 35°E 6.53' nail with tag #24607 northeast side 32" Oak.

C. Description of monument for corner and accessories established to perpetuate locating the position of the corner:


Set concrete monument with Oakland County Remonumentation Brass Cap stamped #24598.

Set Witnesses:

- \*N 56°W 18.28' Mag nail with OCRT #24598 northeast side 14" Maple.
- \*N 45°E 20.12' Mag nail with OCRT #24598 southeast side 14" Beech.
- \*S 35°E 6.53' Mag nail with OCRT #24598 northeast side 32" Oak.
- N 30°W 25.91' Mag nail with OCRT #24598 east side 14" Maple.

\*Reused Recovered Witnesses

A	B	C	D	E	F	G	H	I	J	K	L
2	6	5	4	3	2	1					
3											
4	7	8	9	10	11	12					
5											
6	16	17	18	19	14	13					
7											
8	19	20	21	22	23	24					
9											
10	30	29	28	27	26	25					
11											
12	31	32	33	34	35	36					
13											

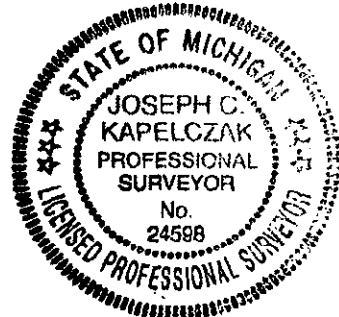

20  
R

Signed by Joseph C. Kapelczak

Date 5/26/99

Surveyor's Michigan License No. 24598