

MAY 24 2000

LAND CORNER RECORDATION CERTIFICATE  
Filing Requirement of Act 74, Mich. P.A. 1970

131654

SECTION

For corners in

|                                       |  |                             |
|---------------------------------------|--|-----------------------------|
| <u>Oakland</u><br>(county)            | Located In:<br><u>Rose Township</u>    | Corner Code #<br><u>J-5</u> |
| 1. Public Land Survey                 | T <u>4</u> N R <u>7</u> E              | <u>J-5</u>                  |
|                                       | T <u>   </u> R <u>   </u>              | <u>   </u>                  |
|                                       | T <u>   </u> R <u>   </u>              | <u>   </u>                  |
|                                       | T <u>   </u> R <u>   </u>              | <u>   </u>                  |
| 2. Property Controlling<br>in Section | S <u>   </u> T <u>   </u> R <u>   </u> | <u>   </u>                  |
|                                       | S <u>   </u> T <u>   </u> R <u>   </u> | <u>   </u>                  |
| 3. Miscellaneous<br>Property in Sec.  | S <u>   </u> T <u>   </u> R <u>   </u> | <u>   </u>                  |
|                                       | S <u>   </u> T <u>   </u> R <u>   </u> | <u>   </u>                  |

LIBER 19843 PAGE 663  
\$9.00 MISC RECORDING  
\$2.00 REMONUMENTATION  
04/16/1999 08:59:50 A.M. RECEIPT# 19968  
PAID RECORDED - OAKLAND COUNTY  
G. WILLIAM CADDELL, CLERK/REGISTER OF DEEDS

Compliance with  
ACT 345, P.A. 1990

APPROVED ON: 3-31-99 JS  
OAKLAND COUNTY REMONUMENTATION  
PEER GROUP COMMITTEE

Register of Deeds Stamp & File Number

4. Lot No. \_\_\_\_\_, Recorded Plat \_\_\_\_\_

5. Private Claims \_\_\_\_\_

I, Joseph C. Kapelczak, in a field survey on March 20, 1998, do hereby certify that under requirements of P.A. 74, Michigan P.A. of 1970, the corner points mentioned in lines 1 and 2 above were in conformance with regulations and rules therefore as required in the current manual of survey instructions of the United States Department of the Interior, Bureau of Land Management or by a decree of a Court of Law and/or that the corner points mentioned in lines 3, 4 and 5 above were in conformance with the rules of the Michigan Board of Land Surveyors or by a Decree of a Court of Law; established, re-established, monumented, re-monumented, recovered, found as expressed below:

NOTE: Not more than 4 corners, all in the same town and range, may be recorded on this certificate.

A. Description of original monument and accessories and/or subsequent restoration:

Set post in 1816 G.L.O. Survey.  
There are two LCRC's recorded at Oakland County, Ward 1980, set iron and Ward 1990, iron.

B. Description of corner evidence found and/or method applied in restoring or reestablishing corner:

Recovered a 1/2" iron in Davisburg Road at this location. This location was validated with monumentation recovered for LAKE BRAEMAR ESTATES #1 and Ward Grant's 1979 recorded Survey in Section 11, L 7593 P 401.

Recovered Witnesses:

- \*N 49°E 27.41' nail in top of guard rail post.
- N 12° W 91.18' nail with Tri-County tag in top of guard rail post.
- \*S 46°W 18.99' nail in top of guard rail post.
- \*S 03°W 50.17' nail east side power pole.

\* Located from previously recorded LCRC's

C. Description of monument for corner and accessories established to perpetuate locating the position of the corner:


Set 5/8" Iron with Oakland County Remonumentation Brass Cap stamped #24598 in new monument box.

Set Witnesses:

- N 54°W 35.88' Mag nail with OCRT stamped #24598 in top of guard rail post.
- S 46°W 18.99 Mag nail with OCRT stamped #24598 in top of guard rail post.
- N 49°E 27.41' Mag nail with OCRT stamped #24598 in top of guard rail post.
- S 03°W 50.17' Mag nail with OCRT stamped #24598 east side power pole.

|    |    |   |    |   |    |   |    |   |    |   |    |   |   |
|----|----|---|----|---|----|---|----|---|----|---|----|---|---|
|    | A  | B | C  | D | E  | F | G  | H | I  | J | K  | L | M |
| 2  | 6  |   | 5  |   | 4  |   | 3  |   | 2  |   | 1  |   |   |
| 3  |    |   |    |   |    |   |    |   |    |   |    |   |   |
| 4  | 7  |   | 8  |   | 9  |   | 10 |   | 11 |   | 12 |   |   |
| 5  |    |   |    |   |    |   |    |   |    |   |    |   |   |
| 6  | 13 |   | 17 |   | 16 |   | 15 |   | 14 |   | 13 |   |   |
| 7  |    |   |    |   |    |   |    |   |    |   |    |   |   |
| 8  | 19 |   | 20 |   | 21 |   | 22 |   | 23 |   | 24 |   |   |
| 9  |    |   |    |   |    |   |    |   |    |   |    |   |   |
| 10 | 30 |   | 29 |   | 28 |   | 27 |   | 26 |   | 25 |   |   |
| 11 |    |   |    |   |    |   |    |   |    |   |    |   |   |
| 12 | 31 |   | 32 |   | 33 |   | 34 |   | 35 |   | 36 |   |   |
| 13 |    |   |    |   |    |   |    |   |    |   |    |   |   |

2P  
R

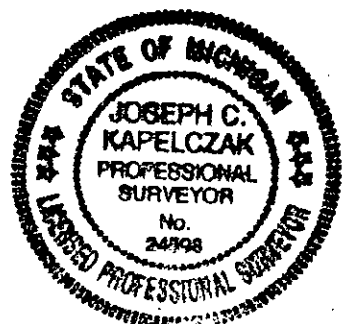

Signed by Joseph C. Kapelczak

Date 3/31/99

Surveyor's Michigan License No. 24598