SURVEY & REMONUMENTATION

MAY 2 4 2000

LIBER 20657 PAGE 384

SECTION

LAND CORNER RECORDATION CERTIFICATE
Filing Requirement of Act 74, Mich. P.A. 1970

374974

LIBER 20657 PAGE 384
$9.00 MISC RECORDING
$2.00 REMONUMENTATION
10/12/1999 08:06:33 A.M. RECEIPT# 88906
PAID RECORDED - OAKLAND COUNTY
G. WILLIAM CADDELL, CLERK/REGISTER OF DEEDS

For corners in

Oakland (county) — Located In: Rose Township — Corner Code #

1. Public Land Survey — T4N R7E K-2
2. Property Controlling in Section — S___ T___ R___
3. Miscellaneous Property in Sec. — S___ T___ R___

Compliance with ACT 345, P.A. 1990
APPROVED ON: 4-4-99 JK
OAKLAND COUNTY REMONUMENTATION PERR GROUP COMMITTEE

Register of Deeds Stamp & File Number

4. Lot No. _____, Recorded Plat _____

5. Private Claims _____

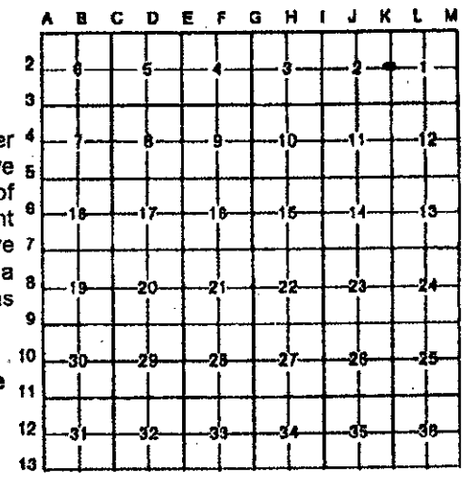

I, Joseph C. Kapelczak, in a field survey on March 5, 1998, do hereby certify that under requirements of P.A. 74, Michigan P.A. of 1970, the corner points mentioned in lines 1 and 2 above were in conformance with regulations and rules therefore as required in the current manual of survey instructions of the United States Department of the Interior, Bureau of Land Management or by a decree of a Court of Law and/or that the corner points mentioned in lines 3, 4 and 5 above were in conformance with the rules of the Michigan Board of Land Surveyors or by a Decree of a Court of Law; established, re-established, monumented, re-monumented, recovered, found as expressed below:

NOTE: Not more than 4 corners, all in the same town and range, may be recorded on this certificate.

A. Description of original monument and accessories and/or subsequent restoration:

Set post in 1816 G.L.O. Survey.
There are no LCRC's recorded at Oakland County.

B. Description of corner evidence found and/or method applied in restoring or reestablishing corner:

No monumentation was recovered at this location as this corner lies within Rattalee Lake. This location was re-established per Grant Ward's Survey as recorded in L.13620 P.329. A reference monument was placed on the line between the location of K-2 and K-3 110.00' south of the corner location.

Recovered Witnesses:

*N 00°E 14.74' nail with Grant Ward tag west side 5" Walnut.
*N 90°E 7.17' nail with Grant Ward tag north side 5" Walnut.
*N 90°E 14.96' nail with Grant Ward tag north side 5" Walnut.

ZP
n

C. Description of monument for corner and accessories established to perpetuate locating the position of the corner:

Set reference monument 110' S of K-2 along K-2 K-3 line with Oakland County Remonumentation Brass Cap stamped #24598.

Set Witnesses:

N 80°E 30.95' Mag nail with OCRT # 24598 south face 6" Elm.
S 49°E 21.01' Mag nail with OCRT #24598 north face 20" Oak.
S 7°W 33.85' Mag nail with OCRT #24598 east face 18" Oak.
S 80°W 21.79' Mag nail with OCRT #24598 north face 24" Oak.

STATE OF MICHIGAN
JOSEPH C. KAPELCZAK
PROFESSIONAL SURVEYOR
No. 24598
LICENSED PROFESSIONAL SURVEYOR

Signed by Joseph C. Kapelczak Date 8/30/99

Surveyor's Michigan License No. 24598

FORM APPROVED BY MICHIGAN STATE BOARD OF LAND SURVEYORS, JAN. 28, 1971
REVISED MAY 14, 1975
REVISED JAN., 1983