

MAY 24 2000

SECTION

LAND CORNER RECORDATION CERTIFICATE  
Filing Requirement of Act 74, Mich. P.A. 1970

374976

For corners in

<u>Oakland</u> (county)	Located In: Rose Township	Corner Code # K-6
1. Public Land Survey	T4N R7E	K-6
	T R	
	T R	
	T R	
2. Property Controlling in Section	S T R	
	S T R	
3. Miscellaneous Property in Sec.	S T R	
	S T R	

LIBER 20657 PAGE 388  
 \$9.00 MISC RECORDING  
 \$2.00 REMONUMENTATION  
 10/12/1999 08:06:33 A.M. RECEIPT# 88906  
 PAID RECORDED - OAKLAND COUNTY  
 G. WILLIAM CADDELL, CLERK/REGISTER OF DEED

Compliance with  
 ACT 345, P.A. 1990

APPROVED ON: 4-27-99 JS  
 OAKLAND COUNTY REMONUMENTATION  
 PEER GROUP COMMITTEE

Register of Deeds Stamp & File Number

4. Lot No. \_\_\_\_\_, Recorded Plat \_\_\_\_\_

5. Private Claims \_\_\_\_\_

I, Joseph C. Kapelczak, in a field survey on March 16, 1998, do hereby certify that under requirements of P.A. 74, Michigan P.A. of 1970, the corner points mentioned in lines 1 and 2 above were in conformance with regulations and rules therefore as required in the current manual of survey instructions of the United States Department of the Interior, Bureau of Land Management or by a decree of a Court of Law and/or that the corner points mentioned in lines 3, 4 and 5 above were in conformance with the rules of the Michigan Board of Land Surveyors or by a Decree of a Court of Law, established, re-established, monumented, re-monumented, recovered, found as expressed below:

NOTE: Not more than 4 corners, all in the same town and range, may be recorded on this certificate.

A. Description of original monument and accessories and/or subsequent restoration:

Set post in 1816 G.L.O. Survey.

There is one LCRC recorded at Oakland County; Ward 1980, set iron cap.

B. Description of corner evidence found and/or method applied in restoring or reestablishing corner:

Recovered an iron with cap at this location. Validated this location with monumentation recovered along the Section Line north and south of the 1/4 corner. There are four recorded surveys that agree with this corner.

Recovered Witnesses:

- \*N 20°E 8.85' nail west side 16" Oak.
- \*N 65°E 3.95' nail northwest side 24" Walnut.
- S 85°E 5.52' nail north side Twin 24" Walnut.
- \*S 30°E 22.06' barn spike northeast side 14" Cherry

C. Description of monument for corner and accessories established to perpetuate locating the position of the corner:


Set concrete monument with Oakland County Remonumentation Brass Cap stamped #24598.

Set Witnesses:

- \*N 20°E 8.85 nail with OCRT #24598 northwest side 16" Oak.
- \*N 65°E 3.95' Mag nail with OCRT #24598 northwest side 24" Walnut.
- S 85°E 5.52' Mag nail with OCRT #24598 north side Twin 24" Walnut.
- S 30°E 22.06' nail with OCRT #24598 northeast side 14" Cherry.

\*Reused Recovered Witnesses

A	B	C	D	E	F	G	H	I	J	K	L
2	6	5	4	3	2	1					
3											
4	7	8	9	10	11	12					
5											
6	13	17	18	15	14	13					
7											
8	19	20	21	22	23	24					
9											
10	30	29	28	27	26	25					
11											
12	31	32	33	34	35	36					
13											

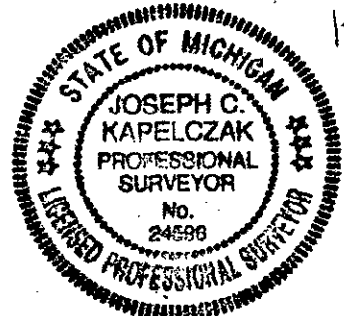

Signed by Joseph C. Kapelczak  
 Surveyor's Michigan License No. 24598

Date 4/28/99