

MAY 24 2000

LIBER 20657 ... 390

SECTION

LAND CORNER RECORDATION CERTIFICATE
Filing Requirement of Act 74, Mich. P.A. 1970

374977

For corners in

<u>Oakland</u> (county)	Located in:	Corner Code #
	Rose Township	
1. Public Land Survey	T4N R7E	K-7
	T R	
	T R	
	T R	
2. Property Controlling in Section	S T R	
	S T R	
3. Miscellaneous Property in Sec.	S T R	
	S T R	

LIBER 20657 PAGE 390
 \$9.00 MISC RECORDING
 \$2.00 REMONUMENTATION
 10/12/1999 08:06:33 A.M. RECEIPT# 88906
 PAID RECORDED - OAKLAND COUNTY
 G. WILLIAM CADDELL, CLERK/REGISTER OF DEEDS

Compliance with
 ACT 345, P.A. 1990
 APPROVED ON: 4-27-99 JS
 OAKLAND COUNTY REMONUMENTATION
 PEER GROUP COMMITTEE
 Register of Deeds Stamp & File Number

4. Lot No. _____, Recorded Plat _____

5. Private Claims _____

I, Joseph C. Kapelczak, in a field survey on October 6, 1998, do hereby certify that under requirements of P.A. 74, Michigan P.A. of 1970, the corner points mentioned in lines 1 and 2 above were in conformance with regulations and rules therefore as required in the current manual of survey instructions of the United States Department of the Interior, Bureau of Land Management or by a decree of a Court of Law and/or that the corner points mentioned in lines 3, 4 and 5 above were in conformance with the rules of the Michigan Board of Land Surveyors or by a Decree of a Court of Law; established, re-established, monumented, re-monumented, recovered, found as expressed below:

NOTE: Not more than 4 corners, all in the same town and range, may be recorded on this certificate.

A	B	C	D	E	F	G	H	I	J	K	L
2		5	4		3				2		
3											
4	7		6		10				11		
5											
6	16	17	18	15	14						
7											
8	19	20	21	22	23						
9											
10	30	29	28	27	26	24					
11											
12	31	32	33	34	35	34					
13											

A. Description of original monument and accessories and/or subsequent restoration:

Set post in 1816 G.L.O. Survey.
 There is one LCRC recorded at Oakland County; Ward 1980.

B. Description of corner evidence found and/or method applied in restoring or reestablishing corner:

Recovered a 1/2" iron with cap #22445 at this location. This location was validated with monumentation recovered along the north line of Section 24 and the south line of Section 14 along with recovered witnesses of the recorded LCRC.

Recovered Witnesses:

- *S 10°E 34.06' found spike east side 20" Oak.
- *S 30°W 7.51' found spike northwest side 8" Oak.


C. Description of monument for corner and accessories established to perpetuate locating the position of the corner:

Set 5/8" rerod with Oakland County Remonumentation Brass Cap stamped #24598 in gravel road.

Set Witnesses:

- N 66°E 50.76' Mag nail with OCRT #24598 south side 10" Oak.
- S 65°E 15.29' Mag nail with OCRT #24598 south side 28" Oak.
- S 71°W 30.10' Mag nail with OCRT #24598 north side 10" Oak.
- *S 10°E 34.06' Mag nail with OCRT #24598 east side 20" Oak.

*Reused Recovered Witnesses

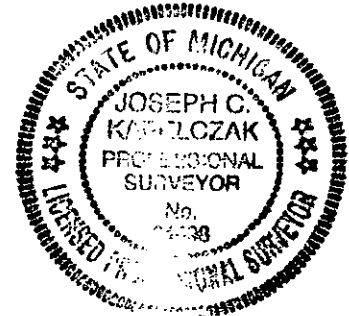

Signed by Joseph C. Kapelczak Date 4/20/99
 Surveyor's Michigan License No. 24598