

SURVEY &  
REMONUMENTATION

MAY 24 2000

LIBER 21119 ... 653

SECTION

LAND CORNER RECORDATION CERTIFICATE  
Filing Requirement of Act 74, Mich. P.A. 1970

51713

For corners in

<u>Oakland</u> (county)	Located in: Rose Township	Corner Code # K-12
1. Public Land Survey	T4N R7E	
	T R	
	T R	
	T R	
2. Property Controlling in Section	S T R	
	S T R	
3. Miscellaneous Property in Sec.	S T R	
	S T R	

LIBER 21119 PAGE 653  
\$9.00 MISC RECORDING  
\$2.00 REMONUMENTATION  
02/18/2000 02:36:27 P.M. RECEIPT# 14203  
PAID RECORDED - OAKLAND COUNTY  
G. WILLIAM CADDELL, CLERK/REGISTER OF DEEDS

APPROVED BY: 8-17-99 JL  
OAKLAND COUNTY ENGINEER  
FERRY GROUP CONSULTING

Register of Deeds Stamp & File Number

4. Lot No. \_\_\_\_\_, Recorded Plat \_\_\_\_\_

5. Private Claims \_\_\_\_\_

I, Joseph C. Kapelczak, in a field survey on April 21, 1998, do hereby certify that under requirements of P.A. 74, Michigan P.A. of 1970, the corner points mentioned in lines 1 and 2 above were in conformance with regulations and rules therefore as required in the current manual of survey instructions of the United States Department of the Interior, Bureau of Land Management or by a decree of a Court of Law and/or that the corner points mentioned in lines 3, 4 and 5 above were in conformance with the rules of the Michigan Board of Land Surveyors or by a Decree of a Court of Law; established, re-established, monumented, re-monumented, recovered, found as expressed below:

**NOTE: Not more than 4 corners, all in the same town and range, may be recorded on this certificate.**

	A	B	C	D	E	F	G	H	I	J	K	L
2	6		5		4		3		2		1	
3												
4	7		8		9		10		11		12	
5												
6	13		17		16		15		14		13	
7												
8	18		20		21		22		23		24	
9												
10	30		29		28		27		26		25	
11												
12	31		32		33		34		35		36	
13												

A. Description of original monument and accessories and/or subsequent restoration:

Set post in 1816 G.L.O. Survey.  
There are no LCRC's recorded at Oakland County.

B. Description of corner evidence found and/or method applied in restoring or reestablishing corner:

Recovered a pinched pipe at this location. The iron as found is on a line between K-12 and K-13 but not set equal distant.

Recovered Witnesses:


- N 43°E 44.34' nail with tag #30092 south side 32" Oak. (Dead)
- N 43°E 45.33' nail northwest side 32" Oak (Dead)
- N 89°E 30.00' nail with tag #30092 in north side 36" Oak.
- S 37°W 29.29' double-headed nail with tag #12584 north side 40" Oak.

C. Description of monument for corner and accessories established to perpetuate locating the position of the corner:

Set concrete monument with Oakland County Remonumentation Brass Cap #24598.

Set Witnesses:

- N 30°W 60.12' Mag nail with OCRT #24598 west side 3 10" Elms.
- East 29.84' Mag nail with OCRT #24598 north side 10" Elm.
- S 69°E 9.81' Mag nail with OCRT #24598 west side 10" Cherry.
- S 37°E 29.26' Mag nail with OCRT #24598 north side 40" Oak.

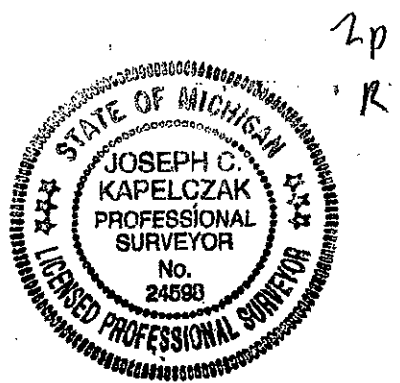

Signed by Joseph C. Kapelczak

Date 8/3/99

Surveyor's Michigan License No. 24598