

MAY 24 2000

LIBER 19843PG657

SECTION

LAND CORNER RECORDATION CERTIFICATE
Filing Requirement of Act 74, Mich. P.A. 1970

131651

For corners in

<u>Oakland</u> (county)	Located In: Rose Township	Corner Code #
1. Public Land Survey	T4N R7E	L-5
	T R	
	T R	
	T R	
2. Property Controlling in Section	S T R	
	S T R	
3. Miscellaneous Property in Sec.	S T R	
	S T R	

LIBER 19843 PAGE 657
 \$9.00 MISC RECORDING
 \$2.00 REMONUMENTATION
 04/16/1999 08:59:50 A.M. RECEIPT# 19968
 PAID RECORDED - OAKLAND COUNTY
 G. WILLIAM CADDELL, CLERK/REGISTER OF DEEDS

Compliance with
 ACT 345, P.A. 1990

APPROVED ON: 3-31-99 55
 OAKLAND COUNTY REMONUMENTATION
 PEER GROUP COMMITTEE
 Register of Deeds Stamp & File Number

4. Lot No. _____, Recorded Plat _____
 5. Private Claims _____

I, Joseph C. Kapelczak, in a field survey on April 22, 1998, do hereby certify that under requirements of P.A. 74, Michigan P.A. of 1970, the corner points mentioned in lines 1 and 2 above were in conformance with regulations and rules therefore as required in the current manual of survey instructions of the United States Department of the Interior, Bureau of Land Management or by a decree of a Court of Law and/or that the corner points mentioned in lines 3, 4 and 5 above were in conformance with the rules of the Michigan Board of Land Surveyors or by a Decree of a Court of Law; established, re-established, monumented, re-monumented, recovered, found as expressed below:

	A	B	C	D	E	F	G	H	I	J	K	L	P
2	6		5		4		3		2		1		
3													
4	7		8		9		10		11		12		
5													
6	13		17		16		15		14		13		
7													
8	19		20		21		22		23		24		
9													
10	30		29		28		27		26		25		
11													
12	31		32		33		34		35		36		
13													

NOTE: Not more than 4 corners, all in the same town and range, may be recorded on this certificate.

A. Description of original monument and accessories and/or subsequent restoration:
 Set post in 1816 G.L.O. Survey.
 There are five LCRC's recorded at Oakland County; Albright 1972, Iron, Scharl 1978, L 7177 P 597, Ward 1981, L 8089 P 43, Ward 1990, L 11645 P 484 and Frisch 1995, L 15304 P 401.


B. Description of corner evidence found and/or method applied in restoring or reestablishing corner:
 Recovered a 1/2" iron in Eagle Road at this location. This location was validated with monumentation recovered from recorded surveys in Section 13.

- Recovered Witnesses:
- *N 30°E 48.88' nail west side 14" Hickory.
 - *S 35°W 38.44' nail east side 10" Walnut.
 - *West 18.84' north west end of culvert.
 - N 02°W 58.91' found nail east side 4-10" Box Elder.

28
R

C. Description of monument for corner and accessories established to perpetuate locating the position of the corner:
 Set Oakland County Remonumentation Brass Cap stamped #24598 with 5/8" rerod in Eagle Road.

- Set Witnesses:
- S 89°E 64.17' Mag nail with OCRT #24598 north side power pole.
 - S 25°W 72.81' Mag nail with OCRT #24598 east side 14" Hickory.
 - N 30°E 48.88' Mag nail with OCRT #24598 west side 14" Oak.
 - N 02°E 58.91' Mag nail with OCRT #24598 east side group of 4 10" Box Elders.

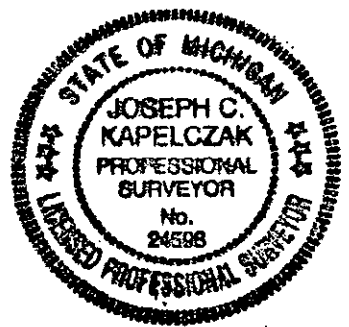

Signed by Joseph C. Kapelczak
 Surveyor's Michigan License No. 24598

Date 3/31/99