

MAY 24 2000

SECTION

LAND CORNER RECORDATION CERTIFICATE
Filing Requirement of Act 74, Mich. P.A. 1970

374980

For corners in

<u>Oakland</u> (county)	Located In: Rose Township	Corner Code #
1. Public Land Survey	T4N R7E L-7	
	T R	
	T R	
	T R	
2. Property Controlling in Section	S T R	
	S T R	
3. Miscellaneous Property in Sec.	S T R	
	S T R	

LIBER 20657 PAGE 396
 \$9.00 MISC RECORDING
 \$2.00 REMONUMENTATION
 10/12/1999 08:06:34 A.M. RECEIPT# 88906
 PAID RECORDED - OAKLAND COUNTY
 G. WILLIAM CADDELL, CLERK/REGISTER OF DEED

Compliance with
 ACT 345, P.A. 1990

APPROVED ON: 4-27-99 JS
 OAKLAND COUNTY REMONUMENTATION
 PEER GROUP COMMITTEE
 Register of Deeds Stamp & File Number

4. Lot No. _____, Recorded Plat _____

5. Private Claims _____

I, Joseph C. Kapelczak, in a field survey on March 25, 1998, do hereby certify that under requirements of P.A. 74, Michigan P.A. of 1970, the corner points mentioned in lines 1 and 2 above were in conformance with regulations and rules therefore as required in the current manual of survey instructions of the United States Department of the Interior, Bureau of Land Management or by a decree of a Court of Law and/or that the corner points mentioned in lines 3, 4 and 5 above were in conformance with the rules of the Michigan Board of Land Surveyors or by a Decree of a Court of Law, established, re-established, monumented, re-monumented, recovered, found as expressed below:

NOTE: Not more than 4 corners, all in the same town and range, may be recorded on this certificate.

A. Description of original monument and accessories and/or subsequent restoration:

Set post in 1816 G.L.O. Survey.
 There is one LCRC recorded at Oakland County; Albright 1972.

B. Description of corner evidence found and/or method applied in restoring or reestablishing corner:

Recovered a 1/2" iron at intersection of Parker and Eagle Roads at this location. This location was validated with monumentation along the R.O.W. of Parker Road and section line east and west of the corner along with two witnesses recovered in the recorded LCRC.

Recovered Witnesses:

- N 20°W 64.91' PK nail with Grant Ward tag east side Twin 18" Oak.
- N 65°W 72.11' PK nail with Grant Ward tag south side power pole.
- *N 65°W 72.14' nail with tag #10057 south side power pole.
- S 53°W 36.97' spike in southeast side 36" stump.
- S 34°W 44.96' Mag nail with Grant Ward tag southeast side 3" Oak.
- S 21°E 55.06' Mag nail with Grant Ward tag west side 34" Poplar.
- *S 55°E 33.59' steel fence post.


C. Description of monument for corner and accessories established to perpetuate locating the position of the corner:

Set 5/8" iron rod with Oakland County Remonumentation Brass Cap stamped #24598 in gravel road.

Set Witnesses:

- S 21°E 55.06' Mag nail with OCRT #24598 west side 34" Poplar.
- S 34°W 44.96' Mag nail with OCRT #24598 east side 3" Oak.
- *N 65°W 72.11' Mag nail with OCRT #24598 south side power pole.
- N 20°W 64.91' Mag nail with OCRT #24598 east side Twin 18" Oak.
- *S 55°E 33.59' steel fence post.

*Reused Recovered Witnesses

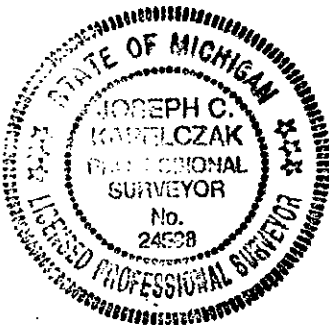

Signed by Joseph C. Kapelczak
 Surveyor's Michigan License No. 24598

Date 4/28/99

	A	B	C	D	E	F	G	H	I	J	K	L
2												
3												
2p
R.