

MAY 24 2000

LAND CORNER RECORDATION CERTIFICATE
Filing Requirement of Act 74, Mich. P.A. 1970

59642

SECTION

For corners in

<u>Oakland</u> (county)	Located In: Rose Township	Corner Code # M-7
1. Public Land Survey	T4N R7E	M-7
	T R	
	T R	
	T R	
2. Property Controlling in Section	S T R	
	S T R	
3. Miscellaneous Property in Sec.	S T R	
	S T R	

LIBER 21146 PAGE 102
 \$9.00 MISC RECORDING
 \$2.00 REMONUMENTATION
 02/29/2000 10:58:27 A.M. RECEIPT# 16518
 PAID RECORDED - OAKLAND COUNTY
 G. WILLIAM CADDELL, CLERK/REGISTER OF DEEDS

Complies with
 ACT 345, P.A. 1990

APPROVED ON: 11-30-99 JN
 OAKLAND COUNTY REMONUMENTATION
 PROGRAM

Register of Deeds Stamp & File Number

4. Lot No. _____, Recorded Plat _____

5. Private Claims _____

I, Joseph C. Kapelczak, in a field survey on May 6, 1998, do hereby certify that under requirements of P.A. 74, Michigan P.A. of 1970, the corner points mentioned in lines 1 and 2 above were in conformance with regulations and rules therefore as required in the current manual of survey instructions of the United States Department of the Interior, Bureau of Land Management or by a decree of a Court of Law and/or that the corner points mentioned in lines 3, 4 and 5 above were in conformance with the rules of the Michigan Board of Land Surveyors or by a Decree of a Court of Law; established, re-established, monumented, re-monumented, recovered, found as expressed below:

	A	B	C	D	E	F	G	H	I	J	K	L
2	6		5		4		3		2		1	
3												
4	7		8		9		10		11		12	
5												
6	16		17		18		19		20		21	
7												
8	19		20		21		22		23		24	
9												
10	30		29		28		27		26		25	
11												
12	31		32		33		34		35		36	
13												

A. Description of original monument and accessories and/or subsequent restoration:

Set post in 1816 G.L.O. Survey.
 There are no LCRC's recorded at Oakland County. There is an Act 132 Survey recorded by McCoy, 1977, L 7031 P 678.

B. Description of corner evidence found and/or method applied in restoring or reestablishing corner:

Recovered a 1/2" iron at this location, 198.09' south of A-7 Springfield Township. Validated the location of this monument with the east line of Beth-Laura Subdivision and the recorded survey by McCoy.

Recovered Witnesses:

- *S 85°W 18.86' nail with Grant Ward washer north side 33" Oak.
- *S 10°W 16.58' nail with Grant Ward washer west side 20" Walnut.
- *S 45°E 1.05' nail with Grant Ward washer northeast side 8" Oak.


C. Description of monument for corner and accessories established to perpetuate locating the position of the corner:

Set concrete monument with Oakland County Remonumentation Brass Cap stamped #24598.

Set Witnesses:

- N 85°E 35.04' Mag nail with OCRT #24598 north side 30" Walnut.
- *S 85°W 18.86' Mag nail with OCRT #24598 north side 33" Walnut.
- *S 10°W 16.58' Mag nail with OCRT #24598 west side 20" Walnut.
- *S 45°E 1.05' Mag nail with OCRT #24598 northeast side 8" Oak.

*Reused Recovered Witnesses

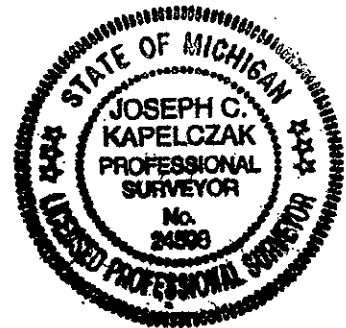

Signed by Joseph C. Kapelczak Date 12/22/99

Surveyor's/Michigan License No. 24598