

MAY 24 2000

LIBER 19237 PG 834

192-498347b

SECTION

LAND CORNER RECORDATION CERTIFICATE

Filing Requirement of Act 74, Mich. P.A. 1970 § 9.00 MISCELLANEOUS RECORDING

For corners in

Oakland

Located in:

Corner Code #

(County)

1. Public Land Survey

T	4N	R	8E	A-2
T		R		
T		R		
T		R		
S		R		
S		R		
S		R		
S		R		

2. Property Controlling in Section

3. Miscellaneous Property in Sec.

\$ 2.00 REMONUMENTATION
 4 DEC 98 8:29 A.M. RECEIPT PAID
 G. WILLIAM CADDRELL
 CLERK/REGISTER OF DEEDS

Compliance with ACT 345, P.A. 1990

APPROVED ON: 3-24-98 JS
 OAKLAND COUNTY REMONUMENTATION
 PEER GROUP COMMITTEE

Register of Deeds Stamp & File Number

4. Lot No. _____, Recorded Plat _____
 5. Private Claims _____

Grant J. Ward, R.L.S. in a field survey on November 14, 1997 do hereby state that under requirements of P.A. 74, Michigan P.A. of 1970, the corner points mentioned in lines 1 and 2 above were in conformance with regulations and rules therefore as required in the current manual of survey instructions of the United States Department of the Interior, Bureau of Land Management or by a decree of a Court of Law and/or that the corner points mentioned in lines 3, 4 and 5 above were in conformance with the rules of the Michigan Board of Land Surveyors or by a Decree of a Court of Law; established, re-established, monumented, recovered, found as expressed below:

NOTE: Not more than 2 corners, all in the same town and range, may be recorded on this certificate.

	A	B	C	D	E	F	G	H	I	J	K	L	M
1													
2	6		5		4		3		2			1	
3													
4	7		8		9		10		11			12	
5													
6	18		17		16		15		14			13	
7													
8	19		20		21		22		23			24	
9													
10	30		29		28		27		26			25	
11													
12	31		32		33		34		35			36	
13													

A. Description of original monument and accessories and/or subsequent restoration:
 A-2 Post, per G.L.O. Notes.

B. Description of corner evidence found and/or method applied in restoring or reestablishing corner:

A-2 West 1/4 Corner of Section 6, T. 4 N., R. 8 E. Found 3/4" Iron Pipe 2' +/- East of Centerline of Weber Road.


Previously Recorded in L. 6961 P. 103 (3), L. 7466 P. 146 (2) and L. 11754 P. 500 (4) of Oakland County Records.

(n) Indicates the number of references that confirms this corner by dimensional tie.

This corner location, although not established by an original government survey, is accepted by the contractor and is generally accepted by professional surveyors as the best available evidence of the position of the corner.

C. Description of monument for corner and accessories established to perpetuate locating the position of the corner:

A-2	Set 5/8" Iron Rod & Remonumentation Cap.				
	N 50° E	21.98'	Set MAG Nail & Remonumentation Disc in Northwest face of 14" Oak.		
	S 40° E	31.53'	Set MAG Nail & Remonumentation Disc in Southwest face of 12" Oak.		
	S 70° W	23.19'	Set MAG Nail & Remonumentation Disc in Southeast face of 12" Oak.		
	N 35° W	29.17'	Set MAG Nail & Remonumentation Disc in Northeast Face of 12" Oak.		
	South	171.43'	Found 1/2" Iron Rod, M-2 Rose Twp.		
	East	33.00'	Found 1/2" Iron Rod & Cap #22445.		

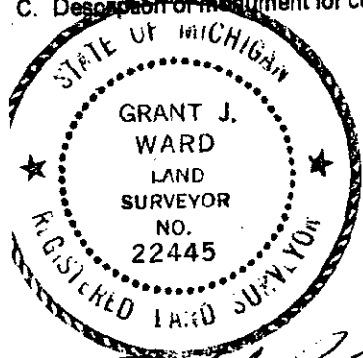

Signed by _____
 Surveyor's Michigan License No. 22445

Date March 20, 1998