

SURVEY & REMONUMENTATION

MAY 24 2000

LIBER 19237PG836

SECTION

LAND CORNER RECORDATION CERTIFICATE
Filing Requirement of Act 74, Mich. P.A. 1970

\$ 9.00 MISCELLANEOUS RECORDING

\$ 2.00 REMONUMENTATION

4 DEC 98 8:29 A.M. RECEIPT # 48
PAID RECORDED - OAKLAND COUNTY
G. WILLIAM CAIDPELL
CLERK/REGISTER OF DEEDS

For corners in

Oakland

Located In:

Corner Code #

(County)

1. Public Land Survey	T	4N	R	8E	A-3
	T		R		
	T		R		
	T		R		
2. Property Controlling in Section	S	T	R		
	S	T	R		
3. Miscellaneous Property in Sec.	S	T	R		
	S	T	R		

Compliance with ACT 345, P.A. 1990

APPROVED ON: 3-24-98 JS
OAKLAND COUNTY REMONUMENTATION PEER GROUP COMMITTEE

Register of Deeds Stamp & File Number

4. Lot No. _____, Recorded Plat _____
5. Private Claims _____

A	B	C	D	E	F	G	H	I	J	K	L	M
1												
2	6	5	4	3	2	1						
3												
4	7	8	9	10	11	12						
5												
6	18	17	16	15	14	13						
7												
8	19	20	21	22	23	24						
9												
10	30	29	28	27	26	25						
11												
12	31	32	33	34	35	36						
13												

Grant J. Ward, R.L.S. November 14 97
I, _____, in a field survey on _____, 19____ do hereby state that under requirements of P.A. 74, Michigan P.A. of 1970, the corner points mentioned in lines 1 and 2 above were in conformance with regulations and rules therefore as required in the current manual of survey instructions of the United States Department of the Interior, Bureau of Land Management or by a decree of a Court of Law and/or that the corner points mentioned in lines 3, 4 and 5 above were in conformance with the rules of the Michigan Board of Land Surveyors or by a Decree of a Court of Law; established, re-established, monumented, recovered, found as expressed below:

NOTE: Not more than 2 corners, all in the same town and range, may be recorded on this certificate.

A. Description of original monument and accessories and/or subsequent restoration:

A-3 Post, per G.L.O. Notes.

B. Description of corner evidence found and/or method applied in restoring or reestablishing corner:

A-3 Northwest Corner of Section 7, T. 4 N., R. 8 E. Found 3/4" Iron Pipe & Obliterated Cap at Centerlines of Weber and Rattalee Lake Roads.


Previously Recorded in L. 6716 P. 748 (0) and L. 11754 P. 500 (0) of Oakland County Records.

(n) Indicates the number of references that confirms this corner by dimensional tie.

This corner location is accepted by the contractor and is generally accepted by professional surveyors as the best available evidence of the position of the original corner.

FILE
200

C. Description of monument for corner and accessories established to perpetuate locating the position of the corner:

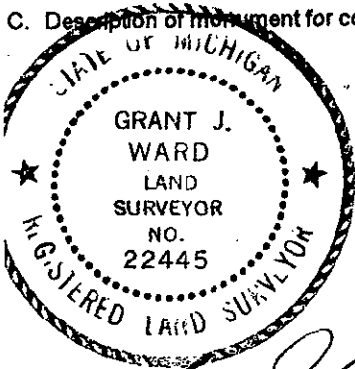

A-3	Set 5/8" Iron Rod and Remonumentation Cap.			
	N 60° E	39.92'	Set MAG Nail & Remonumentation Disc in Northeast face of 10" Elm.	
	S 10° E	37.13'	Set MAG Nail & Remonumentation Disc in Northeast face of 28" Oak.	
	S 35° W	41.30'	Set MAG Nail & Remonumentation Disc in Northwest face of 18" Oak.	
	N 50° W	26.70'	Set MAG Nail & Remonumentation Disc in Northeast face of 10" Hickory.	
	West	3.94'	Found 1/2" Iron Rod.	
	South	10.84'	Found 1/2" Iron Rod.	
	South	170.99'	Found Monument, M-3 Rose Twp.	

Signed by: _____
Surveyor's Michigan License No. 22445

Date March 20, 1998

19237PG836